

Registration Statement

OF CLAIMANT OF RIGHT TO APPROPRIATE GROUND WATER

TO THE STATE ENGINEER OF OREGON:

I, A. L. SHANNON

of R2 County of MARION

State of ORE. do hereby make application for a certificate of registration as evidence of a right to appropriate ground water.

1. Source from which water is withdrawn is Pump well

2. Location is: 1/2 Miles N.W. of SALEM

and is more particularly described as follows:

(a) 460 feet East & 1480 feet South from NW corner Section 28 SW 1/4 of NW 1/4

being within WEST HALF OF WEST HALF of Sec. 28, Twp. 6S, Rge. 3W

or (b) within limits of recorded platted property, town or city:

in Lot _____ Block _____ of _____

County of _____

3. Construction Work was begun on 6-10-54; was completed on 6-11-54

and the ground water claimed was first used for the purposes set out below on 6-15-54

since which time the water has been used Intermittently

from 6-15-54 to 7-23-58

4. Quantity of water claimed and used is 84 gallons per minute; _____ acre feet per year.

5. Purpose or Purposes for which water is used Irrigation

6. Description of Well: Depth 33 feet, Type Drilled

diameter 8 inches. Elevation of ground at well site _____ feet, mean sea level.

Depth to water table 8 feet. Summer measure

7. Capacity of Well: 84 g.p.m. with 4 feet drawdown.

Date of test 6-11-54

If Flowing Well: Measured discharge _____ g.p.m. on _____

Shut-in pressure at ground surface _____ lbs. per sq. in. on _____

Water is controlled by _____

If log of well is not available, give name and address of driller. Willamette Drilling

11. Infiltration Trench: Covered or open

Dimensions: Length ft. Minimum depth ft. Maximum depth ft.

Bottom width ft. Discharge g.p.m. Date of test

12. Tunnel: Type of lining

Dimensions:
(Length, course, and cross sectional size)

Position of water bearing stratum with reference to portal of tunnel

Log of tunnel: (Preceding table for log of well may be used, if desired. Give footage from portal and character of materials, as pertinent.)

13. Pumping Equipment:

(a) Pump Allen Chalmers cent. Capacity 175 g.p.m.
(Make, type and size)

(b) Motor 7 1/2
(Type and horsepower)


14. Location of area irrigated or to be irrigated, or place of use if for purposes other than irrigation.

Township North or South	Range E or W of Willamette Meridian	Section	Forty-acre Tract	Number Acres To Be Irrigated	Date of Reclamation
T65	R3W	28	NW 1/4 of NW 1/4	1.25	1954
T62	R3W	28	SW 1/4 of NW 1/4	4.25	"
				<u>6.00</u>	"

15. If the ground water supply is supplemental to an existing water supply, identification of any application for a permit, permit, certificate or adjudicated right to appropriate water made or held by the registrant.

Township 6S Range 3W W.M.

North

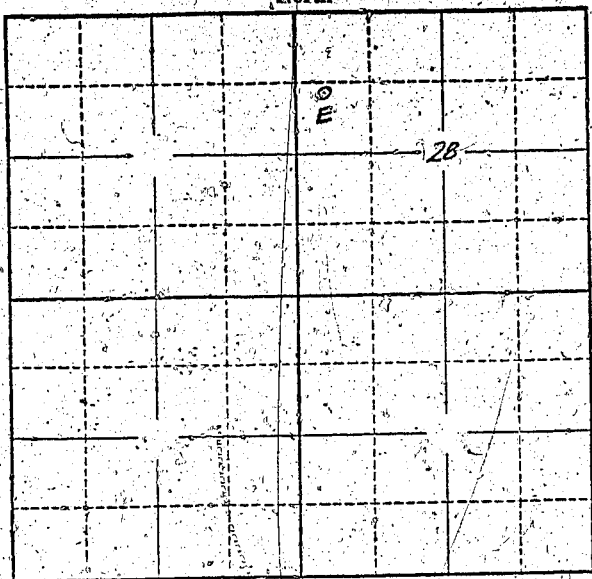

Locate well and acreage of irrigated land on plat.
Scale: 2" = 1 Mile

STATE OF OREGON

County of Marion } ss.

I, Byron E. Stratton, being first duly sworn, do hereby certify that I have read the foregoing Registration Statement and that all of the items therein contained are true to the best of my knowledge and belief.

Byron E. Stratton
(Signature of Registrant)

Subscribed and sworn to before me this 24th day of July, 1958

My commission expires 12th June 1961 Wm. S. Bartholomew
(Notary Public)

(SEAL)

CERTIFICATE OF REGISTRATION

STATE OF OREGON

County of Marion } ss.

This is to certify that the foregoing Registration Statement was received in the office of the State Engineer on the 24th day of July, 1958, at 11:45 o'clock A. M. and has been duly recorded in said office in Book No. 11 of Registration Statements on page GR-2494

Witness my hand this 6th day of April, 1959

Lewis A. Stanley
(State Engineer)

\$15.00

By _____ (Deputy)

GR-2494