RECEIVED
JUL 27 1956

REGISTRATION NO. GR-263
CERTIFICATE NO. GR-185

Registration Statement

OF CLAIMANT OF RIGHT TO APPROPRIATE GROUND WATER

(Under Chapter 708, Oregon Laws 1955.)

TO THE STATE ENGINEER OF OREGON:

We, Harve J. Strahm and Ruth L. Strahm, husband and wife,
of 5277 South Pacific Hwy., Medford, Oregon County of Jackson
State of Oregon, do hereby make application for a certificate of registration as evidence of a right to appropriate ground water.

1. **Source** from which water is withdrawn is Infiltration Trench and tiling (see note under Item 10)
(Flowing well, pump well, infiltration trench, or tunnel)

2. **Location is:** 1 mile North of Talent, Oregon.
(Approximate distance and direction from nearest city or town)

and is more particularly described as follows:

(a) 30' N & 50' W. of SE corner Section 15
(Give distance and bearing to corner of section or other legal subdivision)

being within SE¼ SE¼ (Smallest legal subdivision) of Sec. 15, Twp. 38S (N. or S.), Rge. 1 W. (E. or W.)

or (b) within limits of recorded platted property, town or city:

in Lot ....., Block ..... of ..... (Name of plat or addition)

..... (If within city or town, give name) County of Jackson

3. **Construction Work** was begun on Spring - 1951 (Date); was completed on 1951 (Date)

and the ground water claimed was first used for the purposes set out below on 1951 (Date),

since which time the water has been used continuously (Continuously or intermittently)

from 1951 (Date) to 1956 (Date)

4. **Quantity** of water claimed and used is 750 gallons per minute; ..... acre feet per year.

5. **Purpose or Purposes** for which water is used irrigating truck farm - sprinkling system used.
(Domestic, irrigation, municipal, manufacturing, industrial, etc.)

6. **Description of Well:** Depth ..... feet. Type ..... (Dug or drilled)

diameter ..... inches. Elevation of ground at well site ..... (As near as known) feet, mean sea level.

Depth to water table ..... feet.

7. **Capacity of Well:** ..... g.p.m. with ..... feet drawdown.

..... g.p.m. with ..... feet drawdown.

Date of test .....

If Flowing Well: Measured discharge ..... g.p.m. on ..... (Date)

Shut-in pressure at ground surface ..... lbs. per-sq. in. on ..... (Date)

Water is controlled by ..... (Cap, valve, etc.)

8. **Casing:** (Give diameter, commercial specifications and depth below ground surface of each casing size.)

..... inch diameter ..... from ..... to ..... feet

..... inch diameter ..... from ..... to ..... feet

..... inch diameter ..... from ..... to ..... feet

..... inch diameter ..... from ..... to ..... feet

Describe and show depth of shoe, plug, adapter, liner or other details: .....

.....

.....

9. **Perforated Casings or Screens:**

..... from ..... to .....
(Number per foot and size of perforations, or describe screen)

..... from ..... to .....

..... from ..... to .....

..... from ..... to .....

10. **Log of Well:** (Describe each stratum or formation clearly, indicate if water bearing, and give thickness and depth as indicated.)

MATERIAL	Thickness (Feet)	Depth to Bottom (Feet)
Note: Additional water is piped into infiltration trench which has been developed through tiling the said lands of applicants that lie above the Phoenix Canal in the NE¼ NE¼, Section 22, T. 38 S. R. 1 W., W. M.		

GR-185 A

If log of well is not available, give name and address of driller. .....

11. Infiltration Trench: Covered or open open

Dimensions: Length 160 ft. Minimum depth 4 ft. Maximum depth 20 ft.

Bottom width 40 ft. Discharge 750 g.p.m. Date of test None

Discharge includes water developed by tiling, see note #10 supra.

12. Tunnel: Type of lining .....

Dimensions: .....
(Length, course, and cross sectional size)

Position of water bearing stratum with reference to portal of tunnel .....

Log of tunnel: (Preceding table for log of well may be used, if desired. Give footage from portal and character of materials, as pertinent.)

13. Pumping Equipment:

(a) Pump Two 3" Centrifugal Pumps (Cornell) Capacity 400 g.p.m. each
(Make, type and size)

(b) Motor Two 15 H. P. Electric Motors
(Type and horsepower)

14. Location of area irrigated or to be irrigated, or place of use if for purposes other than irrigation.

Township North or South	Range E. or W. of Willamette Meridian	Section	Forty-acre Tract	Number Acres To Be Irrigated	Date of Reclamation
38 S.	1 W.	14	SW¼ SW¼	21.0	April 15, 1951
		14	SE¼ SW¼	3.9	" " "
		15	SE¼ SW¼	10.0	" " "
		22	NE¼ NE¼	4.5	" " "
		23	NW¼ NW¼	3.4	" " "
		23	NE¼ NW¼	0.6	" " "
			Total	43.4	

15. If the ground water supply is supplemental to an existing water supply, identification of any application for a permit, permit, certificate or adjudicated right to appropriate water made or held by the registrant.

Permit No. 5962; Application No. 9077; Certificate No. 5794 issued in the name of Ella J. Patterson

GR-185B

Township 38 S. Range 1 W., W.M.

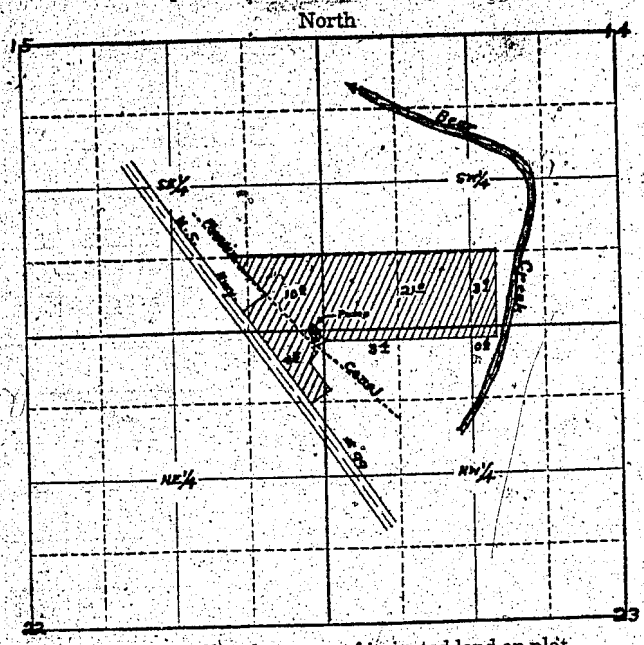

Locate well and acreage of irrigated land on plat.

Scale: 4" = 1 Mile

STATE OF OREGON
County of Jackson } ss.

We, Harve J. Strahm and Ruth D. Strahm, each being first duly sworn, do hereby certify that I have read the foregoing Registration Statement and that all of the items therein contained are true to the best of my knowledge and belief.

Harve J. Strahm
Ruth D. Strahm
(Signature of Registrant)

Subscribed and sworn to before me this 25 day of September, 1956.

My commission expires Oct. 12, 1959 Harry C. Skipman
(Notary Public)

(SEAL)

CERTIFICATE OF REGISTRATION

STATE OF OREGON
County of Marion } ss.

This is to certify that the foregoing Registration Statement was received in the office of the State Engineer on the 27th day of September, 1956, at 8 o'clock A.M. and has been duly recorded in said office in Book No. 1 of Registration Statements on page GR-185 C.

~~Construction shall be completed by X-X-X-X-X-X-X-X-X-X-19X-X and the water completely applied to beneficial use by X-X-X-X-X-X-X-X-X-19X-X~~

Witness my hand this 23rd day of November, 1956.

Lewis A. Stanley
(State Engineer)

By
(Deputy)

GR-185 C