

Debord Well (#2)
\$ 1500

Registration No. GR. 2631

RECEIVED

Registration Statement

Certificate No. GR. 2496

JUL 24 1958
STATE ENGINEER
SALEM, OREGON

CLAIMANT OF RIGHT TO APPROPRIATE GROUND WATER

TO THE STATE ENGINEER OF OREGON:

I, Earl B Hathaway
of Rt # 3 Corvallis, Oregon County of Benton
(Mailing address)

State of Oregon, do hereby make application for a certificate of registration as evidence of a right to appropriate ground water.

1. Source from which water is withdrawn is Pump Well
(Flowing well, pump well, infiltration trench, or tunnel)

2. Location is: S.E. 7 miles from Corvallis
(Approximate distance and direction from nearest city or town)

and is more particularly described as follows:

(a) 96 2/3 ft N & 3149 75 ft E from the W 1/4 corner of section 30
(Give distance and bearing to corner of section or other legal subdivision)

being within SW 1/4 NE 1/4 of Sec. 30, Twp. 12 S, Rge. 4 W
(Smallest legal subdivision) (N. or S.) (E. or W.)

or (b) within limits of recorded platted property, town or city:

in Lot _____, Block _____ of _____
(Name of plat or addition)

County of Benton
(If within city or town, give name)

3. Construction Work was begun on May 1950; was completed on June 1950
(Date) (Date)

and the ground water claimed was first used for the purposes set out below on June 1950,
(Date)

since which time the water has been used during Irrigation Season
(Continuously or Intermittently)

from 1950 to 1955
(Date) (Date)

4. Quantity of water claimed and used is 200 gallons per minute; _____ acre feet per year.

5. Purpose or Purposes for which water is used Irrigation

(Domestic, irrigation, municipal, manufacturing, industrial, etc.)

6. Description of Well: Depth 25 feet. Type Driven
(Dug or drilled)

diameter 2 1/2 inches. Elevation of ground at well site _____ feet, mean sea level.
(As near as known)

Depth to water table 12 feet.

7. Capacity of Well: 200? g.p.m. with ? feet drawdown.

_____ g.p.m. with _____ feet drawdown.

Date of test _____

If Flowing Well: Measured discharge _____ g.p.m. on _____
(Date)

Shut-in pressure at ground surface _____ lbs. per sq. in. on _____
(Date)

Water is controlled by _____
(Cap, valve, etc.)

8. Casing: (Give diameter, commercial specifications and depth below ground surface of each casing size.)

2½ inch diameter from 0 to 25 feet
 inch diameter from to feet
 inch diameter from to feet
 inch diameter from to feet

Describe and show depth of shoe, plug, adapter, liner or other details:

9. Perforated Casings or Screens:

(Number per foot and size of perforations, or describe screen) from to
 from to
 from to
 from to

10. Log of Well: (Describe each stratum or formation clearly, indicate if water bearing, and give thickness and depth as indicated.)

MATERIAL	Thickness (Feet)	Depth to Bottom (Feet)
Soil	12	
Gravel	12	

If log of well is not available, give name and address of driller.

11. Infiltration Trench: Covered or open

Dimensions: Length _____ ft. Minimum depth _____ ft. Maximum depth _____ ft.
 Bottom width _____ ft. Discharge _____ g.p.m. Date of test _____

12. Tunnel: Type of lining

Dimensions: _____
(Length, course, and cross sectional size)

Position of water bearing stratum with reference to portal of tunnel _____

Log of tunnel: (Preceding table for log of well may be used, if desired. Give footage from portal and character of materials, as pertinent.)

13. Pumping Equipment:


(a) Pump Atlas Furber Morse 3/4" Capacity 450 g.p.m.
(Make, type and size)
 (b) Motor Atlas Chalmer 3 h.p.
(Type and horsepower)

14. Location of area irrigated or to be irrigated, or place of use if for purposes other than irrigation.

Township North or South	Range E. or W. of Willamette Meridian	Section	Forty-acre Tract	Number Acres To Be Irrigated	Date of Reclamation
12 S	4 W	30	SW 1/4 NE 1/4	10	1950
"	"	"	SE 1/4 NW 1/4	5	1950
				<u>15</u>	

15. If the ground water supply is supplemental to an existing water supply, identification of any application for a permit, permit, certificate or adjudicated right to appropriate water made or held by the registrant.

Township 0125 Range 4W, W.M.
North

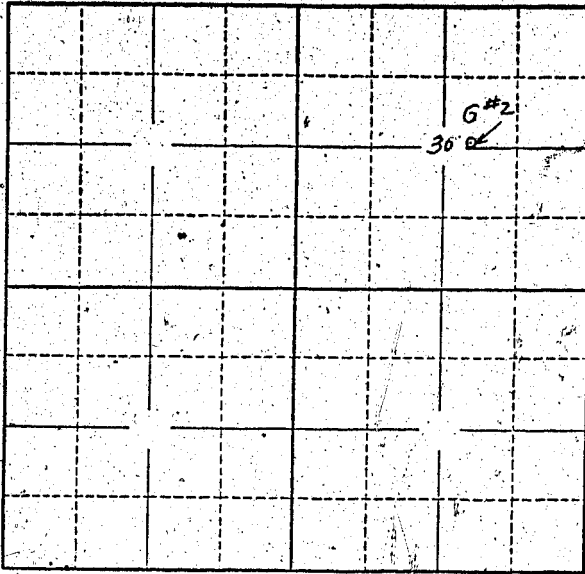

Locate well and acreage of irrigated land on plat.
Scale: 2" = 1 Mile

STATE OF OREGON

County of Marion } ss.

I, Earl B. Hathaway, being first duly sworn, do hereby certify that I have read the foregoing Registration Statement and that all of the items therein contained are true to the best of my knowledge and belief.

Earl B. Hathaway
(Signature of Registrant)

Subscribed and sworn to before me this 24 day of July, 1958.

My commission expires 9/27/58

Jehanne Baster
(Notary Public)

(SEAL)

CERTIFICATE OF REGISTRATION

STATE OF OREGON } ss.
County of Marion

This is to certify that the foregoing Registration Statement was received in the office of the State Engineer on the 24th day of July, 1958, at 9:30 o'clock A.M. and has been duly recorded in said office in Book No. 11 of Registration Statements on page GR-2496

Witness my hand this 6th day of April, 1959

Laura A. Stanley
(State Engineer)

\$1,500

By _____ (Deputy)