

Registration Statement

OF CLAIMANT OF RIGHT TO APPROPRIATE GROUND WATER

TO THE STATE ENGINEER OF OREGON:

I, ALVIN Schwengel

of 5715 Van Cleave Rd Salem County of Marion

State of Oregon, do hereby make application for a certificate of registration as evidence of a right to appropriate ground water.

1. Source from which water is withdrawn is Pump Well

2. Location is: 5 Miles N. E. Salem

and is more particularly described as follows:

(a) 1031 ft. East and 390 ft. South from NW cor. Sec 4

being within N.W. N.W. 4 of Sec. 4, Twp. 7 S, Rge. 2 W

or (b) within limits of recorded platted property, town or city:

in Lot _____, Block _____ of _____

County of Marion

3. Construction Work was begun on Oct. 16, 1952 was completed on Oct. 22, 1952

and the ground water claimed was first used for the purposes set out below on April 1, 1953

since which time the water has been used In Termittently each season

from April 1, 1952 to July 24, 1958

4. Quantity of water claimed and used is 350 gallons per minute; 61 acre feet per year.

5. Purpose or Purposes for which water is used Irrigation

6. Description of Well: Depth 145 feet. Type Drilled

diameter 10 inches. Elevation of ground at well site 216 feet, mean sea level.

Depth to water table 30 feet.

7. Capacity of Well: 560 g.p.m. with 15 feet drawdown.

_____ g.p.m. with _____ feet drawdown.

Date of test 10/22/52

If Flowing Well: Measured discharge _____ g.p.m. on _____

Shut-in pressure at ground surface _____ lbs. per sq. in. on _____

Water is controlled by _____

8. Casing: (Give diameter, commercial specifications and depth below ground surface of each casing size.)

10 inch diameter Steel from 0 to 145 feet
 inch diameter from to feet
 inch diameter from to feet
 inch diameter from to feet

Describe and show depth of shoe, plug, adapter, liner or other details:

9. Perforated Casings or Screens:

Steel Perforated Every 2 FT. 6 holes - More or Less from to
(Number per foot and size of perforations, or describe screen)
1-2 in. x 1/4 in hole size from 80 to 124 FT
 " " " " from 130 to 145 FT
 " " " " from to

10. Log of Well: (Describe each stratum or formation clearly; indicate if water bearing, and give thickness and depth as indicated.)

MATERIAL	Thickness (Feet)	Depth to Bottom (Feet)
SOIL AND SAND FORMATION	30	30
SOIL AND SAND FORMATION, WATER BEARING	30	60
BROWN SANDY CLAY	10	70
SANDY GRAVEL, WATER BEARING	4	74
MUD SAND	6	80
CEMENT GRAVEL, WATER BEARING	44	124
DARK GREY SANDY MUD	6	130
CEMENT GRAVEL, WATER BEARING	15	145

If log of well is not available, give name and address of driller. _____

11. Infiltration Trench: Covered or open _____
 Dimensions: Length _____ ft. Minimum depth _____ ft. Maximum depth _____ ft.
 Bottom width _____ ft. Discharge _____ g.p.m. Date of test _____

12. Tunnel: Type of lining _____
 Dimensions: _____
(Length, course, and cross sectional size)
 Position of water bearing stratum with reference to portal of tunnel _____

Log of tunnel: (Preceding table for log of well may be used, if desired. Give footage from portal and character of materials, as pertinent.) _____

13. Pumping Equipment:
 (a) Pump 8" Deep Well Turbine (Berkeley) capacity 350 g.p.m.
(Make, type and size)
 (b) Motor 15 H.P. 220-440 Volt
(Type and horsepower)


14. Location of area irrigated or to be irrigated, or place of use if for purposes other than irrigation.

Township North or South	Range E. or W. of Williamsite Meridian	Section	Forty-acre Tract	Number Acres To Be Irrigated	Date of Reclamation
7 S	2 W	4	NW $\frac{1}{4}$ NW $\frac{1}{4}$	19.24	Oct. 22, 1952
"	"	"	NE $\frac{1}{4}$ NW $\frac{1}{4}$	12.26	"
"	"	"	NW $\frac{1}{4}$ NE $\frac{1}{4}$	4.13	"
				<u>35.63</u>	"

15. If the ground water supply is supplemental to an existing water supply, identification of any application for a permit, permit, certificate or adjudicated right to appropriate water made or held by the registrant.

Township 7 S Range 2 W W.M.
North

N. West Sect 1022

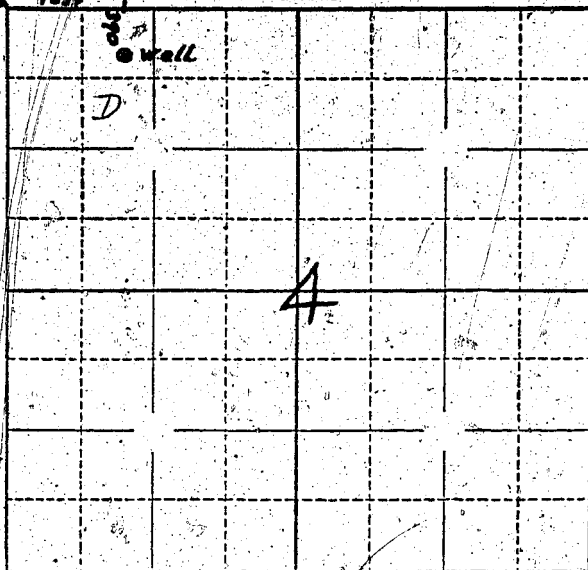

Locate well and acreage of irrigated land on plat.
Scale: $\frac{1}{4}$ - 1 Mile

STATE OF OREGON

County of Marion } ss.

I, Alvin Schraengel, being first duly sworn, do hereby certify that I have read the foregoing Registration Statement and that all of the items therein contained are true to the best of my knowledge and belief.

Alvin Schraengel
(Signature of Registrant)

Subscribed and sworn to before me this 24th day of July, 1958

My commission expires 12th June 1961

Wm. S. Bartholomew
(Notary Public)

(SEAL)

CERTIFICATE OF REGISTRATION

STATE OF OREGON

County of Marion } ss.

This is to certify that the foregoing Registration Statement was received in the office of the State Engineer on the 24 day of July, 1958, at 12:00 o'clock A. M. and has been duly recorded in said office in Book No. 11 of Registration Statements on page GR-2528

Witness my hand this 6th day of April, 1959.

Lewis A. Stanley
(State Engineer)

By _____
(Deputy)

GR - 2528

\$ 15.20