

# Registration Statement

## OF CLAIMANT OF RIGHT TO APPROPRIATE GROUND WATER

TO THE STATE ENGINEER OF OREGON:

I, Harley R. Miller

of P. O. Box 195 Glendale County of Douglas  
(Mailing address)

State of Oregon do hereby make application for a certificate of registration as evidence of a right to appropriate ground water.

1. Source from which water is withdrawn is drill well  
(Flowing well, pump well, infiltration trench, or tunnel)

2. Location is: in Glendale  
(Approximate distance and direction from nearest city or town)

and is more particularly described as follows: Place of beginning north east 299.0 ft. to About 950 feet west of 720 feet North of SE Corner Section 32.

(a) the well, thence southeast corner 234.08 ft north thence 252.02  
(Give distance and bearing to corner of section or other legal subdivision) ft west to well.  
being within part of the southeast quarter of Sec. 32, Twp. 32 S, Rge. R 6 W  
(Smallest legal subdivision) (N. or S.) (E. or W.)

or (b) within limits of recorded platted property, town or city:

in Lot \_\_\_\_\_, Block \_\_\_\_\_ of faces on 6th St. in the town of Glendale  
(Name of plat or addition)

County of \_\_\_\_\_  
(If within city or town, give name)

3. Construction Work was begun on May, 1955; was completed on May, 1955  
(Date) (Date)

and the ground water claimed was first used for the purposes set out below on right way 1955  
(Date)

since which time the water has been used intermittently  
(Continuously or intermittently)

from May, 1955 to present time  
(Date) (Date)

4. Quantity of water claimed and used is 1 1/2 gallons per minute; \_\_\_\_\_ acre feet per year.

5. Purpose or Purposes for which water is used irrigation

(Domestic, irrigation, municipal, manufacturing, industrial, etc.)

6. Description of Well: Depth 65 feet. Type drilled  
(Dug or drilled)

diameter 12 inches. Elevation of ground at well site 1120 feet, mean sea level.  
(As near as known)

Depth to water table 5 feet.

7. Capacity of Well: \_\_\_\_\_ g.p.m. with \_\_\_\_\_ feet drawdown.

\_\_\_\_\_ g.p.m. with \_\_\_\_\_ feet drawdown.

Date of test May, 1955

If Flowing Well: Measured discharge 126 g.p.m. on May, 1955  
(Date)


Shut-in pressure at ground surface \_\_\_\_\_ lbs. per sq. in. on \_\_\_\_\_  
(Date)

Water is controlled by \_\_\_\_\_  
(Cap. valve, etc.)





Township 32 S Range 6 W W.M.  
North

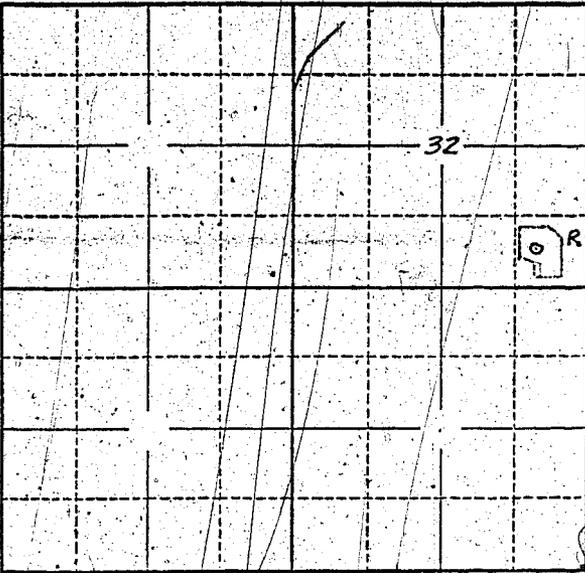

Locate well and acreage of irrigated land on plat.  
Scale: 2" = 1 Mile

STATE OF OREGON

County of Josephine } ss.

I, Harley A. Miller, being first duly sworn, do hereby certify that I have read the foregoing Registration Statement and that all of the items therein contained are true to the best of my knowledge and belief.

*Harley A. Miller*  
(Signature of Registrant)

Subscribed and sworn to before me this 11th day of July, 1958.

My commission expires 2/27/61

*Mayorie Green*  
(Notary Public)

(SEAL)

CERTIFICATE OF REGISTRATION

STATE OF OREGON

County of Marion } ss.

This is to certify that the foregoing Registration Statement was received in the office of the State Engineer on the 24 day of July, 1958, at 8:00 o'clock A.M. and has been duly recorded in said office in Book No. 11 of Registration Statements on page GR-2497

Witness my hand this 6th day of April, 1959

*Stuart G. Stanley*  
(State Engineer)

By \_\_\_\_\_ (Deputy)

\$15.00