

Registration No. GR 2635

Certificate No. GR 2499

Registration Statement

OF CLAIMANT OF RIGHT TO APPROPRIATE GROUND WATER

TO THE STATE ENGINEER OF OREGON:

I, Joseph E. McIntyre and Thelma C. McIntyre, husband and wife
of P. O. Box 25 (200 8th St.) Jacksonville County of Jackson
(Mailing address)

State of Oregon, do hereby make application for a certificate of registration as evidence of a right to appropriate ground water.

1. Source from which water is withdrawn is dug well with tunnel
(Flowing well, pump well, infiltration trench, or tunnel)

2. Location is: In City of Jacksonville
(Approximate distance and direction from nearest city or town)

and is more particularly described as follows:

(a) 2075 feet west & 1040 feet south from NE Corner Section 32
(Give distance and bearing to corner of section or other legal subdivision)

being within NW 1/4 of NE 1/4 of Sec. 32, Twp. 37S, Rge. 2W
(Smallest legal subdivision) (N, S, or W)

or (b) within limits of recorded platted property, town or city:

in Lot _____, Block 65 of Pool & Klippel Addition Town of Jacksonville
(Name of plat or addition)
Jacksonville County of Jackson
(If within city or town, give name)

3. Construction Work was begun on 1932 in Fall; was completed on Same year
(Date) (Date)

and the ground water claimed was first used for the purposes set out below on during irrigation season
of 1933
(Date)

since which time the water has been used continuously during irrigation season
(Continuously or intermittently)
from 1933 to 1958
(Date) (Date)

4. Quantity of water claimed and used is undetermined 15 gpm gallons per minute; _____ acre
feet per year.

5. Purpose or Purposes for which water is used for garden, pasture, berries, fruit
trees, on area designated on accompanying map
(Domestic, irrigation, municipal, manufacturing, industrial, etc.)

6. Description of Well: Depth 25 feet. Type dug
(Dug or drilled)
diameter 5 feet inches. Elevation of ground at well site 1300 ± feet, mean sea level.
(As near as known)
Depth to water table 15 feet.

7. Capacity of Well: no test made g.p.m. with _____ feet drawdown.
_____ g.p.m. with _____ feet drawdown.


Date of test none made

not a flowing well
If Flowing Well: Measured discharge _____ g.p.m. on _____
(Date)

Shut-in pressure at ground surface _____ lbs. per sq. in. on _____
(Date)

Water is controlled by _____
(Cap, valve, etc.)

Township 37 S Range 2 W W.M.
North

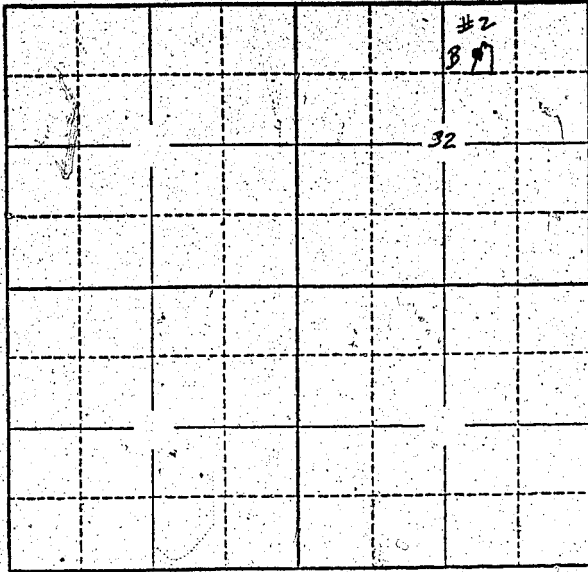

Locate well and acreage of irrigated land on plat.
Scale: 2" = 1 Mile

STATE OF OREGON }
County of Jackson } ss.

I, Joseph E. McIntyre & Thelma G. McIntyre, being first duly sworn, do hereby certify that I have read the foregoing Registration Statement and that all of the items therein contained are true to the best of my knowledge and belief.

Joseph E. McIntyre
Thelma G. McIntyre
(Signature of Registrant)

Subscribed and sworn to before me this 22nd day of July, 1958

My commission expires Nov. 23-1960
Richard Reed
(Notary Public) for Oregon

(SEAL)

CERTIFICATE OF REGISTRATION

STATE OF OREGON }
County of Marion } ss.

This is to certify that the foregoing Registration Statement was received in the office of the State Engineer on the 24 day of July, 1958, at 8:00 o'clock A. M. and has been duly recorded in said office in Book No. 11 of Registration Statements on page GR-2499

Witness my hand this 6th day of April, 1959
Lewis A. Stanley
(State Engineer)

By _____
(Deputy)

#1500