

Registration No. GR 2636

Certificate No. GR 3997

Registration Statement

RECEIVED
FEB 29 1960

CLAIMANT OF RIGHT TO APPROPRIATE GROUND WATER

STATE ENGINEER
OREGON

TO THE STATE ENGINEER OF OREGON:

I, REUBEN C. SANDNESS AND JOYCE V. SANDNESS, husband and wife
of 13725 S. W. Fern, Tigard, 23, Oregon County of WASHINGTON
(Mailing address)

State of OREGON, do hereby make application for a certificate of registration as evidence of a right to appropriate ground water.

1. Source from which water is withdrawn is DRILLED PUMP WELL
(Flowing well, pump well, infiltration trench, or tunnel)

2. Location is: 2 1/2 mile West of Tigard
(Approximate distance and direction from nearest city or town)

and is more particularly described as follows: 1930 feet east & 980 feet north from W 1/4 corner Section 4

(a) LOTS 4, 5, and 6, HANDY ACRES
(Give distance and bearing to corner of section or other legal subdivision)

being within SE 1/4 of NW 1/4 of Sec. 4, Twp. 2 South, Rge. 1 West
(Smallest legal subdivision) (N. or S.) (E. or W.)

or (b) within limits of recorded platted property, town or city: Not within limits

in Lot 4, Block II of 4, 5, 6
(Name of plat or addition)

(If within city or town, give name) County of Wash.

3. Construction Work was begun on 1949; was completed on 1949
(Date) (Date)

and the ground water claimed was first used for the purposes set out below on 1949
(Date)

since which time the water has been used contin.
(Continuously or Intermittently)

from 1949 to 1958
(Date) (Date)

4. Quantity of water claimed and used is 16 gallons per minute; acre feet per year.

5. Purpose or Purposes for which water is used Residence and one acre garden site

(Domestic, irrigation, municipal, manufacturing, industrial, etc.)

6. Description of Well: Depth 178 feet. Type drilled
(Dug or drilled)

diameter 6 inches. Elevation of ground at well site 300 feet, mean sea level.
(As near as known)

Depth to water table 145 feet.

7. Capacity of Well: 16 g.p.m. with nil feet drawdown.

g.p.m. with feet drawdown.

Date of test

If Flowing Well: Measured discharge g.p.m. on
(Date)

Shut-in pressure at ground surface lbs. per sq. in. on
(Date)

Water is controlled by (Cap, valve, etc.)

8. **Casing:** (Give diameter, commercial specifications and depth below ground surface of each casing size.)

..... six inch diameter 63 feet to rock (basalt) from to feet
..... inch diameter from to feet
..... inch diameter from to feet
..... inch diameter from to feet

Describe and show depth of shoe, plug, adapter, liner or other details:

9. **Perforated Casings or Screens:**

..... from to
(Number per foot and size of perforations, or describe screen)
..... from to
..... from to
..... from to

10. **Log of Well:** (Describe each stratum or formation clearly, indicate if water bearing, and give thickness and depth as indicated.)

MATERIAL	Thickness (Feet)	Depth to Bottom (Feet)

If log of well is not available, give name and address of driller.

11. Infiltration Trench: Covered or open

Dimensions: Length ft. Minimum depth ft. Maximum depth ft.

Bottom width ft. Discharge g.p.m. Date of test

12. Tunnel: Type of lining

Dimensions:
(Length, course, and cross sectional size)

Position of water bearing stratum with reference to portal of tunnel

Log of tunnel: (Preceding table for log of well may be used, if desired. Give footage from portal and character of materials, as pertinent.)

13. Pumping Equipment:

(a) Pump red jacket submersible 1½ horse Capacity 16 g.p.m.
(Make, type and size)


(b) Motor submersible one & one half horse
(Type and horsepower)

14. Location of area irrigated or to be irrigated, or place of use if for purposes other than irrigation.

Township North or South	Range E. or W. of Willamette Meridian	Section	Forty-acre Tract	Number Acres To Be Irrigated	Date of Reclamation
T2S	R1W	4	SE¼ of NW¼	1 acre 1.2	1949

15. If the ground water supply is supplemental to an existing water supply, identification of any application for a permit, permit, certificate or adjudicated right to appropriate water made or held by the registrant.

Township 25 Range 1 W, W.M.
North

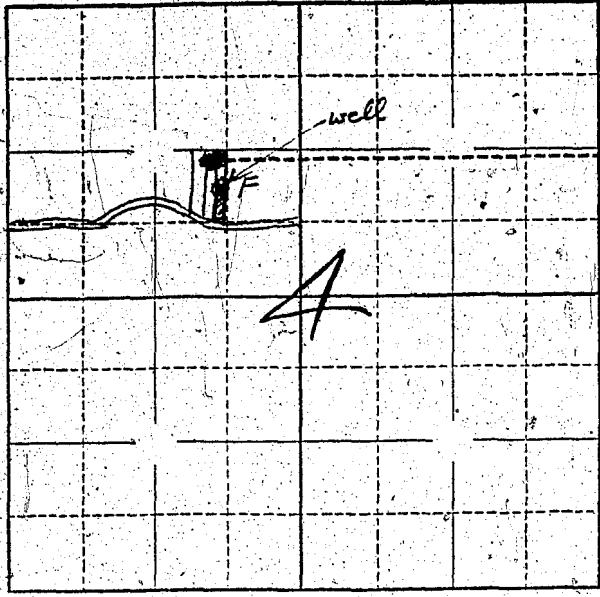

Locate well and acreage of irrigated land on plat.

Scale: $\frac{1}{4}$ " = 1 Mile

STATE OF OREGON

County of WASHINGTON } ss.

REUBEN C. SANDNESS
I, JOYCE V. SANDNESS, being first duly sworn, do hereby certify that I have read the foregoing Registration Statement and that all of the items therein contained are true to the best of my knowledge and belief.

Reuben C. Sandness
Joyce V. Sandness
(Signature of Registrant)

Subscribed and sworn to before me this 12th day of July, 1958.

My commission expires July 24, 1961

John F. [Signature]
(Notary Public)

(SEAL)

CERTIFICATE OF REGISTRATION

STATE OF OREGON } ss.

County of Marion

This is to certify that the foregoing Registration Statement was received in the office of the State Engineer on the 24th day of July, 1958, at 8:00 o'clock A. M. and has been duly recorded in said office in Book No. 16 of Registration Statements on page GR- 3997

Witness my hand this 15th day of March, 1960

Lewis A. Stanton
(State Engineer)

By _____ (Deputy)

\$15.00

GR 3997