

Registration Statement

OF CLAIMANT OF RIGHT TO APPROPRIATE GROUND WATER

TO THE STATE ENGINEER OF OREGON: (Infiltration Trench)
(Warren 12 acres. .)

I, Oscar H. Loa

of Route 1, Box 144, Silverton, Ore. County of Marion
(Mailing address)

State of Oregon, do hereby make application for a certificate of registration as evidence of a right to appropriate ground water.

1. Source from which water is withdrawn is Infiltration trench #4
(Flowing well, pump well, infiltration trench, or tunnel)

2. Location is: 2 miles east and 1/2 mile north of Silverton, in Evens Valley
(Approximate distance and direction from nearest city or town)

and is more particularly described as follows:

(a) North 11 degrees and 37 min. east 1412 ft. from SW corner Sec 30 T6S
(Give distance and bearing to corner of section or other legal subdivision) R1E W1
being within NW 1/4 of SW 1/4 of Sec. 30, Twp. 6S, Rge. 1E
(Smallest legal subdivision) (N. or S.) (E. or W.)

or (b) within limits of recorded platted property, town or city:

in Lot _____, Block _____ of _____
(Name of plat or addition)

County of _____
(If within city or town, give name)

3. Construction Work was begun on 1950; was completed on 1952
(Date) (Date)

and the ground water claimed was first used for the purposes set out below on June 1952
(Date)

since which time the water has been used Intermittently
(Continuously or intermittently)

from June 1952 to July 1953
(Date) (Date)

4. Quantity of water claimed and used is 175 gallons per minute; _____ acre feet per year.

5. Purpose or Purposes for which water is used Irrigation

trench (Domestic, irrigation, municipal, manufacturing, industrial, etc.)

6. Description of Well: Depth 12 feet. Type _____
(Dug or drilled)

diameter _____ inches. Elevation of ground at well site _____ feet, mean sea level.
(As near as known)

Depth to water table _____ feet.

7. Capacity of Well: _____ g.p.m. with _____ feet drawdown.

_____ g.p.m. with _____ feet drawdown.


Date of test _____

If Flowing Well: Measured discharge _____ g.p.m. on _____
(Date)

Shut-in pressure at ground surface _____ lbs. per sq. in. on _____
(Date)

Water is controlled by _____
(Cap, valve, etc.)

Township 6S Range 1E, W.M.
North

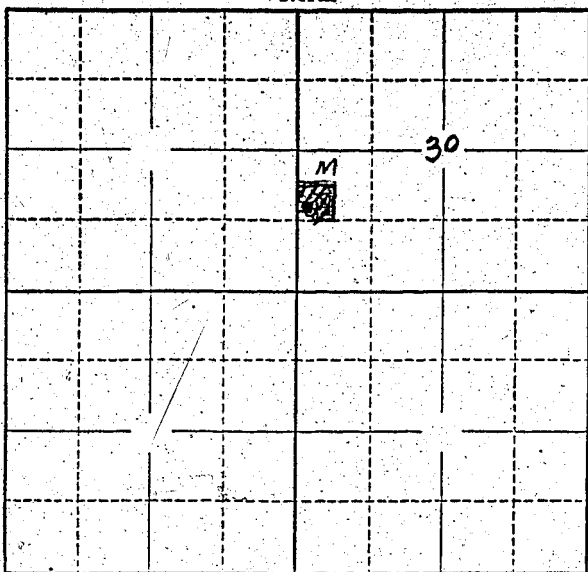

Locate well and acreage of irrigated land on plat.
Scale: 2" = 1 Mile

STATE OF OREGON

County of Marion } ss.

I, Oscar H. Lae, being first duly sworn, do hereby certify that I have read the foregoing Registration Statement and that all of the items therein contained are true to the best of my knowledge and belief.

Oscar H. Lae
(Signature of Registrant)

Subscribed and sworn to before me this 24 day of July, 1958

My commission expires 12th June 1961 Wm S. Bartholomew
(Notary Public)

(SEAL)

CERTIFICATE OF REGISTRATION

STATE OF OREGON

County of Marion } ss.

This is to certify that the foregoing Registration Statement was received in the office of the State Engineer on the 24th day of July, 1958, at 11:00 o'clock A. M. and has been duly recorded in said office in Book No. 11 of Registration Statements on page GR-2500

Witness my hand this 6th day of April, 1959

Lewis A. Stanley
(State Engineer)

By _____ (Deputy)

#1500