

Well #1

REGISTRATION NO. GR-264

Registration Statement CERTIFICATE NO. GR-244

OF CLAIMANT OF RIGHT TO APPROPRIATE GROUND WATER

(Under Chapter 708, Oregon Laws 1955.)

TO THE STATE ENGINEER OF OREGON:

I, Olson-Ross Lumber Co., Inc., an Oregon corporation, with principal office in  
Medford County of Jackson

State of Oregon, do hereby make application for a certificate of registration as evidence of a right to appropriate ground water.

1. Source from which water is withdrawn is pump well

(Flowing well, pump well, infiltration trench, or tunnel)

2. Location is: approximately eight miles northeast of Medford

(Approximate distance and direction from nearest city or town)

and is more particularly described as follows:

(a) 1375 feet south and 950 feet east of the Northwest corner of Section 20, Township 36  
South, Range 1 West of the Willamette Meridian

being within SW 1/4 NW 1/4 of Sec. 20, Twp. 36S, Rge. 1W

(Smallest legal subdivision)

(N. or S.)

(E. or W.)

or (b) within limits of recorded platted property, town or city:

in Lot \_\_\_\_\_, Block \_\_\_\_\_ of \_\_\_\_\_

(Name of plat or addition)

\_\_\_\_\_ County of \_\_\_\_\_

(If within city or town, give name)

3. Construction Work was begun on about March 1, 1951; was completed on March 15, 1951

(Date)

(Date)

and the ground water claimed was first used for the purposes set out below on April 1, 1951

(Date)

since which time the water has been used continuously

(Continuously or intermittently)

from April 1, 1951 to Present

(Date)

(Date)

4. Quantity of water claimed and used is 30 gallons per minute; \_\_\_\_\_ acre feet per year.

5. Purpose or Purposes for which water is used maintaining log pond and cooling water for gang saw and compressor (industrial)

(Domestic, irrigation, municipal, manufacturing, industrial, etc.)

6. Description of Well: Depth 80 feet. Type drilled

(Dug or drilled)

diameter 6 inches. Elevation of ground at well site 1325 feet, mean sea level.

(As near as known)

Depth to water table 20 feet.

7. Capacity of Well: 35 g.p.m. with 10 feet drawdown,

30 g.p.m. with 8 feet drawdown.

Date of test February 2, 1956

If Flowing Well: Measured discharge \_\_\_\_\_ g.p.m. on \_\_\_\_\_

(Date)

Shut-in pressure at ground surface \_\_\_\_\_ lbs. per sq. in. on \_\_\_\_\_

(Date)

Water is controlled by \_\_\_\_\_

(Cap, valve, etc.)

8. Casing: (Give diameter, commercial specifications and depth below ground surface of each casing size.)

6 inch diameter ..... from full depth to ..... feet  
 ..... inch diameter ..... from ..... to ..... feet  
 ..... inch diameter ..... from ..... to ..... feet  
 ..... inch diameter ..... from ..... to ..... feet

Describe and show depth of shoe, plug, adapter, liner or other details: .....  
 .....  
 .....

9. Perforated Casings or Screens:

6 x 1/2" slots 6 per foot ..... from ground to 30 ft.  
(Number per foot and size of perforations, or describe screen)

..... from ..... to .....  
 ..... from ..... to .....  
 ..... from ..... to .....

10. Log of Well: (Describe each stratum or formation clearly, indicate if water bearing, and give thickness and depth as indicated.)

MATERIAL	Thickness (Feet)	Depth to Bottom (Feet)

If log of well is not available, give name and address of driller: Goff Bros., Medford, Oregon.

**11. Infiltration Trench: Covered or open** \_\_\_\_\_

Dimensions: Length \_\_\_\_\_ ft. Minimum depth \_\_\_\_\_ ft. Maximum depth \_\_\_\_\_ ft.

Bottom width \_\_\_\_\_ ft. Discharge \_\_\_\_\_ g.p.m. Date of test \_\_\_\_\_

**12. Tunnel: Type of lining** \_\_\_\_\_

Dimensions: \_\_\_\_\_  
(Length, course, and cross sectional size)

Position of water bearing stratum with reference to portal of tunnel \_\_\_\_\_

Log of tunnel: (Preceding table for log of well may be used, if desired. Give footage from portal and character of materials, as pertinent.)

**13. Pumping Equipment:**

(a) Pump Fairbanks Morse \_\_\_\_\_ Capacity 2,000 g.p.m.  
(Make, type and size)

(b) Motor Fairbanks Morse - 5 hp. 440 V - 60 cyc. \_\_\_\_\_  
(Type and horsepower)


**14. Location of area irrigated or to be irrigated, or place of use if for purposes other than irrigation.**

Township North or South	Range E. or W. of Willamette Meridian	Section	Forty-acre Tract	Number Acres To Be Irrigated	Date of Reclamation
36 S	1 W, W.M.	20	SW 1/4 of NW 1/4;	None	April 1, 1951
			NW 1/4 of NW 1/4;	(industrial use	
			NE 1/4 of NW 1/4	described above)	
			and SW 1/4 of NW 1/4		

15. If the ground water supply is supplemental to an existing water supply, identification of any application for a permit, permit, certificate or adjudicated right to appropriate water made or held by the registrant.

None

Township 36 S Range 1 W W.M.  
North

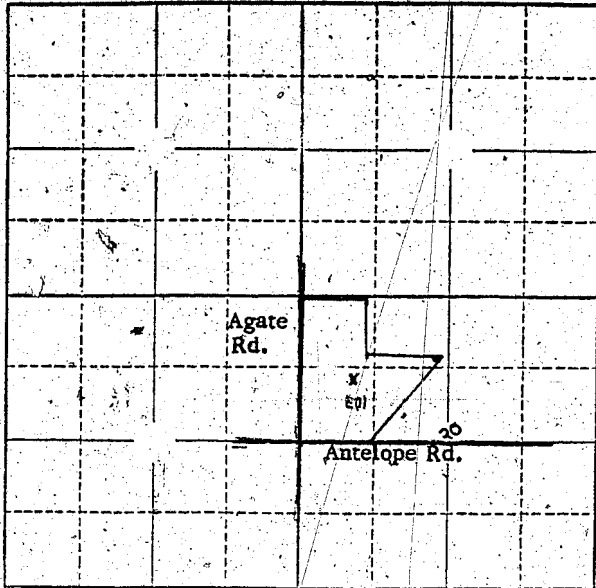

Locate well and acreage of irrigated land on plat.  
Scale: 2" = 1 Mile

State of Oregon )  
                  ) ss.  
County of Jackson )

I, Frank G. Martin, being first duly sworn, depose and say that I am the assistant secretary of Olson-Ross Lumber Co., Inc., an Oregon corporation, having its principal offices in Medford, Jackson county, Oregon, and that I am duly authorized to make the above and foregoing registration statement of claimant of right to appropriate ground water for and on behalf of said corporation, and I do hereby certify that I have read the foregoing registration statement and that all of the items therein contained are true to the best of my knowledge and belief.

*Frank G. Martin*  
\_\_\_\_\_  
Frank G. Martin

Subscribed and sworn to before me this 20 day of September, 1956.

*Gene Nelson*  
\_\_\_\_\_  
Notary Public for Oregon  
My commission expires 12/31/57

SEE PAGE GR-244-G FOR  
CERTIFICATE OF REGISTRATION

STATE OF OREGON )  
                  ) ss.  
County of Marion )

~~This is to certify that the foregoing Registration Statement was received in the office of the State Engineer on the 20 day of September, 1956, at Medford, Oregon, and has been duly recorded in said office in Book No. 154 of Registration Statements on page 154.~~

~~Construction shall be completed by 154 day of January, 1957.~~

~~Witness my hand this 15th day of January, 1957.~~

.....  
(State Engineer)  
By .....  
(Deputy)

GR-244C

Well #2

## Registration Statement

## OF CLAIMANT OF RIGHT TO APPROPRIATE GROUND WATER

(Under Chapter 708, Oregon Laws 1955.)

TO THE STATE ENGINEER OF OREGON:

I, Olson-Ross Lumber Co., Inc., an Oregon corporation, with principal office inMedford County of JacksonState of Oregon, do hereby make application for a certificate of registration as evidence of a right to appropriate ground water.1. Source from which water is withdrawn is pump well #2  
(Flowing well, pump well, infiltration trench, or tunnel)2. Location is: approximately 8 miles northeast of Medford  
(Approximate distance and direction from nearest city or town)

and is more particularly described as follows:

(a) 530 feet east + 1675 feet south of Northwest corner of Section 20, Township 36 South, Range 1 West of Willamette Meridian  
(Approximate distance and bearing to corner of section or other legal subdivision)being within SW 1/4 of Sec. 20, Twp. 36 S, Rge. 1 W  
(Smallest legal subdivision) (N. or S.) (E. or W.)

or (b) within limits of recorded platted property, town or city:

in Lot \_\_\_\_\_, Block \_\_\_\_\_ of \_\_\_\_\_  
(Name of plat or addition)County of \_\_\_\_\_  
(If within city or town, give name)3. Construction Work was begun on May 1, 1955; was completed on May 19, 1955  
(Date) (Date)and the ground water claimed was first used for the purposes set out below on April 1, 1955  
(Date)since which time the water has been used continuously  
(Continuously or intermittently)from April 1, 1955 to present  
(Date) (Date)4. Quantity of water claimed and used is 30 gallons per minute; \_\_\_\_\_ acre feet per year.5. Purpose or Purposes for which water is used maintaining log pond and sprinkling cold deck  
(Industrial)  
(Domestic, irrigation, municipal, manufacturing, industrial, etc.)6. Description of Well: Depth 240 feet. Type drilled  
(Dug or drilled)diameter 6 inches. Elevation of ground at well site 1325.55 feet, mean sea level.  
(As near as known)Depth to water table unknown feet.7. Capacity of Well: 30 g.p.m. with 50 feet drawdown. Maximum25 g.p.m. with 30 feet drawdown. Normal operationDate of test May 5, 1951If Flowing Well: Measured discharge \_\_\_\_\_ g.p.m. on \_\_\_\_\_  
(Date)Shut-in pressure at ground surface \_\_\_\_\_ lbs. per sq. in. on \_\_\_\_\_  
(Date)Water is controlled by \_\_\_\_\_  
(Cap, valve, etc.)

GR-244D

8. Casing: (Give diameter, commercial specifications and depth below ground surface of each casing size.)

6 inch diameter ..... from surface to 50 feet  
..... inch diameter ..... from ..... to ..... feet  
..... inch diameter ..... from ..... to ..... feet  
..... inch diameter ..... from ..... to ..... feet

Describe and show depth of shoe, plug, adapter, liner or other details: .....  
.....  
.....

9. Perforated Casings or Screens:

No perforations

(Number, size and size of perforations, or describe screen)

from ..... to .....  
from ..... to .....  
from ..... to .....  
from ..... to .....

10. Log of Well: (Describe each stratum or formation clearly, indicate if water bearing, and give thickness and depth as indicated.)

MATERIAL	Thickness (Feet)	Depth to Bottom (Feet)

If log of well is not available, give name and address of driller: Goff Bros., Medford, Oregon

11. Infiltration Trench: Covered or open \_\_\_\_\_

Dimensions: Length \_\_\_\_\_ ft. Minimum depth \_\_\_\_\_ ft. Maximum depth \_\_\_\_\_ ft.

Bottom width \_\_\_\_\_ ft. Discharge \_\_\_\_\_ g.p.m. Date of test \_\_\_\_\_

12. Tunnel: Type of lining \_\_\_\_\_

Dimensions: \_\_\_\_\_  
(Length, course, and cross sectional size)

Position of water bearing stratum with reference to portal of tunnel \_\_\_\_\_

Log of tunnel: (Preceding table for log of well may be used, if desired. Give footage from portal and character of materials, as pertinent.)

13. Pumping Equipment:

(a) Pump Fairbanks Morse Capacity 50 g.p.m.  
(Make, type and size)

(b) Motor Fairbanks Morse 5 HP - 440 V - 60 cyc  
(Type and horsepower)

14. Location of area irrigated or to be irrigated, or place of use if for purposes other than irrigation.

Township North or South	Range E. or W. of Willamette Meridian	Section	Forty-acre Tract	Number Acres To Be Irrigated	Date of Reclamation
36 S	1 W WM	20	SW 1/4 of NW 1/4;	None	April 1, 1955
			NW 1/4 of NW 1/4;	(industrial use	
			NE 1/4 of NW 1/4	described above)	
			and SW 1/4 of NW 1/4		

15. If the ground water supply is supplemental to an existing water supply, identification of any application for a permit, permit, certificate or adjudicated right to appropriate water made or held by the registrant.

