

15-4

Registration No. GR 2640

Certificate No. GR 2502

Registration Statement

OF CLAIMANT OF RIGHT TO APPROPRIATE GROUND WATER

TO THE STATE ENGINEER OF OREGON:

I, Oakway Golf Course by Ralph A. Hope
 of 700 Cal Young Rd. County of Lane
(Mailing address)
 State of Ore., do hereby make application for a certificate of registration as evidence
 of a right to appropriate ground water.

1. Source from which water is withdrawn is Pump Well #1
(Flowing well, pump well, infiltration trench, or tunnel)

2. Location is: 3 mi. N.E. of Eugene
(Approximate distance and direction from nearest city or town)

and is more particularly described as follows:

(a) 1677 S + 75 W Sec. NE Corner CW. Young D.C.
(Give distance and bearing to corner of section or other legal subdivision)
 being within NE 1/4 SW 1/4 of Sec. 20, Twp. 17 S, Rge. 3 W
(Smallest legal subdivision) (N. or S.) (E. or W.)

or (b) within limits of recorded platted property, town or city: _____

in Lot _____, Block _____ of _____
(Name of plat or addition)

County of _____
(If within city or town, give name)

3. Construction Work was begun on 1950; was completed on 1950
(Date) (Date)

and the ground water claimed was first used for the purposes set out below on 1950
(Date)

since which time the water has been used Intermittently
(Continuously or Intermittent)

from May to Oct.
(Date) (Date)

4. Quantity of water claimed and used is 250 gallons per minute; _____ acre
 feet per year.

5. Purpose or Purposes for which water is used _____

Irrigate Golf Course
(Domestic, irrigation, municipal, manufacturing, industrial, etc.)

6. Description of Well: Depth 25 feet. Type Drilled
(Dug or drilled)

diameter 5 inches. Elevation of ground at well site _____ feet, mean sea level.
(As near as known)

Depth to water table 3 feet.

7. Capacity of Well: 250 g.p.m. with _____ feet drawdown.

_____ g.p.m. with _____ feet drawdown.


Date of test No test

If Flowing Well: Measured discharge _____ g.p.m. on _____
(Date)

Shut-in pressure at ground surface _____ lbs. per sq. in. on _____
(Date)

Water is controlled by _____
(Cap, valve, etc.)

Township 175 Range 3W W.M.
North

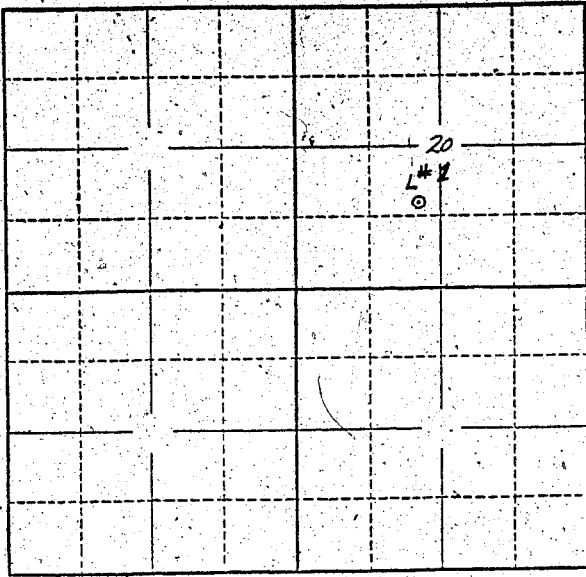

Locate well and acreage of irrigated land on plat.
Scale: 2" = 1 Mile

STATE OF OREGON }
County of Marion } ss.

I, Ralph Arfape, being first duly sworn, do hereby certify that I have read the foregoing Registration Statement and that all of the items therein contained are true to the best of my knowledge and belief.

Robney Lyle Course
Ralph Arfape
(Signature of Registrant)

Subscribed and sworn to before me this 24th day of July, 1958

My commission expires 12th June 1961 Wm. S. Bartholomew
(Notary Public)

(SEAL)

CERTIFICATE OF REGISTRATION

STATE OF OREGON }
County of Marion } ss.

This is to certify that the foregoing Registration Statement was received in the office of the State Engineer on the 24th day of July, 1958, at 2:00 o'clock P.M. and has been duly recorded in said office in Book No. 11 of Registration Statements on page GR 2502

Witness my hand this 6th day of April, 1959
Lewis A. Stanley
(State Engineer)

#15-25

By _____
(Deputy)