

# Registration Statement

## OF CLAIMANT OF RIGHT TO APPROPRIATE GROUND WATER

TO THE STATE ENGINEER OF OREGON:

I, Oakway Golf Course by Ralph A Hope  
of 700 Cal Young Rd. County of Lane  
(Mailing address)

State of Ore., do hereby make application for a certificate of registration as evidence of a right to appropriate ground water.

1. Source from which water is withdrawn is pumped water hole  
(Flowing well, pump well, infiltration trench, or tunnel)
2. Location is: 3 m. N.E. of Eugene  
(Approximate distance and direction from nearest city or town)

and is more particularly described as follows:

(a) 1248' W + 1041' S from NE corner CW Young DL P.  
(Give distance and bearing to corner of section or other legal subdivision)  
being within NW 1/4 SW 1/4 of Sec. 20, Twp. 17 S, Rge. 3 W  
(Smallest legal subdivision) (N. or S.) (E. or W.)

or (b) within limits of recorded platted property, town or city:

in Lot \_\_\_\_\_, Block \_\_\_\_\_ of \_\_\_\_\_  
(Name of plat or addition)  
County of \_\_\_\_\_  
(If within city or town, give name)

3. Construction Work was begun on 1950; was completed on 1950  
(Date) (Date)

and the ground water claimed was first used for the purposes set out below on 1950  
(Date)

since which time the water has been used Intermittently  
(Continuously or intermittently)

from May to Oct.  
(Date) (Date)

4. Quantity of water claimed and used is 800 gallons per minute; \_\_\_\_\_ acre feet per year.

5. Purpose or Purposes for which water is used \_\_\_\_\_

Irrigate Golf Course  
(Domestic, irrigation, municipal, manufacturing, industrial, etc.)

6. Description of Well: Depth 20 feet. Type Dug  
(Dug or drilled)

diameter 42 x 70 inches. Elevation of ground at well site \_\_\_\_\_ feet, mean sea level.  
(As near as known)

Depth to water table 3 feet.

7. Capacity of Well: \_\_\_\_\_ g.p.m. with No test feet drawdown.

\_\_\_\_\_ g.p.m. with \_\_\_\_\_ feet drawdown.

Date of test No test

If Flowing Well: Measured discharge \_\_\_\_\_ g.p.m. on \_\_\_\_\_  
(Date)


Shut-in pressure at ground surface \_\_\_\_\_ lbs. per sq. in. on \_\_\_\_\_  
(Date)

Water is controlled by \_\_\_\_\_  
(Cap, valve, etc.)





Township 17S Range 3W W.M.  
North

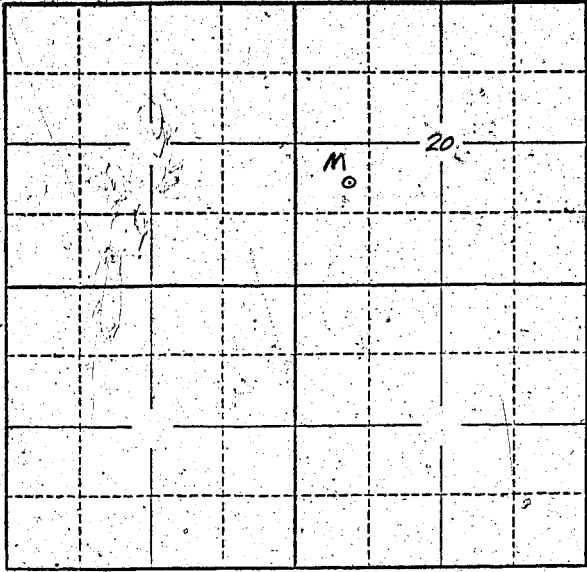

Locate well and acreage of irrigated land on plat.  
Scale: 2" = 1 Mile

STATE OF OREGON }  
County of Marion } ss.

I, Ralph A. Lape, being first duly sworn, do hereby certify that I have read the foregoing Registration Statement and that all of the items therein contained are true to the best of my knowledge and belief.

Robert L. Lape  
Ralph A. Lape  
(Signature of Registrant)

Subscribed and sworn to before me this 24th day of July, 1958.

My commission expires 12th June 1961 Wm. S. Bartholomew  
(Notary Public)

(SEAL)

**CERTIFICATE OF REGISTRATION**

STATE OF OREGON }  
County of Marion } ss.

This is to certify that the foregoing Registration Statement was received in the office of the State Engineer on the 24th day of July, 1958, at 2:00 o'clock P. M. and has been duly recorded in said office in Book No. 11 of Registration Statements on page GR-2503

Witness my hand this 6th day of April, 1959.  
Laura A. Stanley  
(State Engineer)

# 22-95

By \_\_\_\_\_  
(Deputy)

GR - 2503