

RECEIVED  
JUL 24 1958  
STATE ENGINEER  
SALEM, OREGON

Registration No. GR. 2642  
Certificate No. GR. 2504

### Registration Statement

#### OF CLAIMANT OF RIGHT TO APPROPRIATE GROUND WATER

TO THE STATE ENGINEER OF OREGON:

I, Bertha Rhoad  
of Rt 2 Box 369 Milton-Freewater County of Wasmuth  
(Mailing address)

State of Oregon, do hereby make application for a certificate of registration as evidence of a right to appropriate ground water.

1. Source from which water is withdrawn is Pump Well  
(Flowing well, pump well, infiltration trench, or tunnel)
2. Location is: 2 1/2 miles NW of Milton-Freewater  
(Approximate distance and direction from nearest city or town)

and is more particularly described as follows:

(a) 710 feet west & 18 feet North of E<sup>4</sup> Corner  
(Give distance and bearing to corner of section or other legal subdivision)  
being within SW<sup>4</sup> of SE<sup>4</sup> of NE<sup>4</sup> of Sec. 34, Twp. 6N, Rge. 35E  
(Smallest legal subdivision) (N. or S.) (E. or W.)

or (b) within limits of recorded platted property, town or city:

in Lot \_\_\_\_\_, Block \_\_\_\_\_ of \_\_\_\_\_  
(Name of plat or addition)  
County of \_\_\_\_\_  
(If within city or town, give name)

3. Construction Work was begun on 1900; was completed on 1900 1948  
(Date) (Date) *Drilled Deeper*

and the ground water claimed was first used for the purposes set out below on 1900  
(Date)  
since which time the water has been used Continuously  
(Continuously or Intermittently)  
from 1900 to 1958  
(Date) (Date)

4. Quantity of water claimed and used is 4.50 gallons per minute; 50 acre feet per year.

5. Purpose or Purposes for which water is used Irrigation

6. Description of Well: Depth 39 Drilled 39 feet. Type Dug & Drilled  
(Domestic, irrigation, municipal, manufacturing, industrial, etc.) (Dug or drilled)  
diameter 6 1/2" Drill 8" inches. Elevation of ground at well site 950 feet, mean sea level.  
(As near as known)  
Depth to water table 27 feet.

7. Capacity of Well: 45 g.p.m. with 5 feet drawdown;  
\_\_\_\_\_ g.p.m. with \_\_\_\_\_ feet drawdown.

Date of test Dec 1948

If Flowing Well: Measured discharge L g.p.m. on \_\_\_\_\_  
(Date)

Shut-in pressure at ground surface \_\_\_\_\_ lbs. per sq. in. on \_\_\_\_\_  
(Date)

Water is controlled by \_\_\_\_\_  
(Cap. valve, etc.)

8. Casing: (Give diameter, commercial specifications and depth below ground surface of each casing size.)

6' <sup>foot</sup> diameter ..... Concrete ..... from 0 to 15 feet  
8 inch diameter ..... steel ..... from 39 to 49 feet  
..... inch diameter ..... from ..... to ..... feet  
..... inch diameter ..... from ..... to ..... feet

Describe and show depth of shoe, plug, adapter, liner or other details: .....

9. Perforated Casings or Screens:

..... from ..... to .....  
(Number per foot and size of perforations, or describe screen)  
..... from ..... to .....  
..... from ..... to .....  
..... from ..... to .....

10. Log of Well: (Describe each stratum or formation clearly, indicate if water bearing, and give thickness and depth as indicated.)

No Information on Log Port.

MATERIAL	Thickness (Feet)	Depth to Bottom (Feet)
<u>Concrete rock</u>	<u>39</u>	<u>78</u>

If log of well is not available, give name and address of driller. *Drilled by Earl Sheeridge*

11. Infiltration Trench: Covered or open .....

Dimensions: Length ..... ft. Minimum depth ..... ft. Maximum depth ..... ft.

Bottom width ..... ft. Discharge ..... g.p.m. Date of test *1*

12. Tunnel: Type of lining .....

Dimensions: .....  
(Length, course, and cross sectional size)

Position of water bearing stratum with reference to portal of tunnel .....

Log of tunnel: (Preceding table for log of well may be used, if desired. Give footage from portal and character of materials, as pertinent.)

13. Pumping Equipment:

(a) Pump *Centrifugal 4" Dis.* Capacity *450* g.p.m.  
(Make, type and size)

(b) Motor *5HP Elec.*  
(Type and horsepower)


14. Location of area irrigated or to be irrigated, or place of use if for purposes other than irrigation.

Township North or South	Range E. or W. of Willamette Meridian	Section	Forty-acre Tract	Number Acres To Be Irrigated	Date of Reclamation
<i>6N</i>	<i>35E</i>	<i>34</i>	<i>SE<sup>4</sup> of NE<sup>4</sup></i>	<i>9<sup>3</sup>/<sub>10</sub> Acre</i>	<i>1900</i>

15. If the ground water supply is supplemental to an existing water supply, identification of any application for a permit, permit, certificate or adjudicated right to appropriate water made or held by the registrant.

*Surplus water right little Wells Wells since from May to July last*

Township 6N Range 35E W.M.  
North

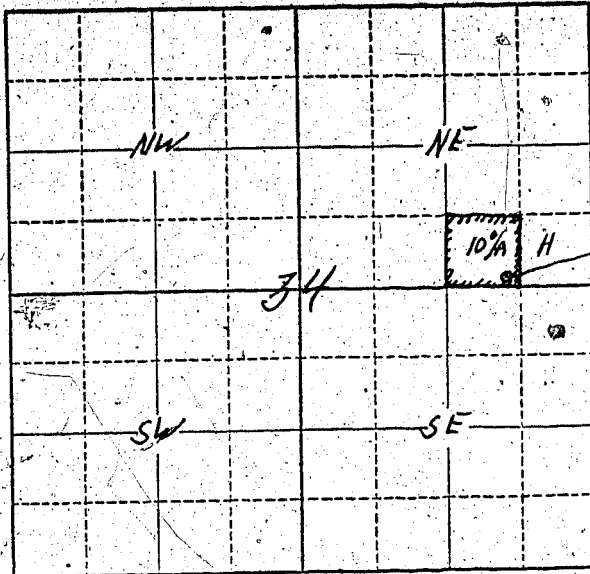

well Location  
710 feet West  
& 18 feet North  
of E<sup>4</sup> Corner  
of Sec 34

Locate well and acreage of irrigated land on plat.

Scale:  $\frac{1}{4}$ " = 1 Mile

STATE OF OREGON


I, Bertha Phea, being first duly sworn, do hereby certify that I have read the foregoing Registration Statement and that all of the items therein contained are true to the best of my knowledge and belief.

Bertha Phea  
(Signature of Registrant)

Subscribed and sworn to before me this 22nd day of July, 1958

My commission expires Feb 29, 1959

Larry Jones  
(Notary Public)

(SEAL)

CERTIFICATE OF REGISTRATION

STATE OF OREGON

County of Marion } ss.

This is to certify that the foregoing Registration Statement was received in the office of the State Engineer on the 24th day of July, 1958, at 1.00 o'clock P. M. and has been duly recorded in said office in Book No. 11 of Registration Statements on page GR 2504

Witness my hand this 6th day of April, 1959

Lewis A. Stanley  
(State Engineer)

By \_\_\_\_\_ (Deputy)

#1500

GR - 2504