

RECEIVED  
JUL 24 1953  
STATE ENGINEER  
SALEM, OREGON

REGISTRATION NO. GR-2646  
CERTIFICATE NO. GR-2508

### Registration Statement

#### OF CLAIMANT OF RIGHT TO APPROPRIATE GROUND WATER

(Under Chapter 708, Oregon Laws 1955.)

TO THE STATE ENGINEER OF OREGON:

I, Fred S. Grath  
of Milton-Freewater County of Umatilla  
State of Oregon, do hereby make application for a certificate of registration as evidence  
of a right to appropriate ground water.

1. Source from which water is withdrawn is pumping well  
(Flowing well, pump well, infiltration trench, or tunnel)

2. Location is: 1 1/2 miles N.W. of Freewater  
(Approximate distance and direction from nearest city or town)

and is more particularly described as follows:

(a) 650 feet South 100 feet West of the East 1/4 corner Sec 34  
(Give distance and bearing to corner of section or other legal subdivision)

being within N 1/2 - NE 1/4 - SE 1/4 of Sec. 34, Twp. 6 N, Rge. 35 E  
(Smallest legal subdivision) (N. or S.) (E. or W.)

or (b) within limits of recorded platted property, town or city: \_\_\_\_\_

in Lot \_\_\_\_\_, Block \_\_\_\_\_ of \_\_\_\_\_  
(Name of plat or addition)

County of \_\_\_\_\_  
(If within city or town, give name)

3. Construction Work was begun on 1909; was completed on 1918  
(Date) (Date)

and the ground water claimed was first used for the purposes set out below on 1909  
(Date)

since which time the water has been used continuously  
(Continuously or intermittently)

from 1909 to 1957  
(Date) (Date)

4. Quantity of water claimed and used is 400 gallons per minute; \_\_\_\_\_  
feet per year.

5. Purpose or Purposes for which water is used Irrigation

(Domestic, irrigation, municipal, manufacturing, industrial, etc.)

6. Description of Well: Depth 94 feet. Type Dug 44 ft. drilled 50 ft.  
(Dug or drilled)

diameter \_\_\_\_\_ inches. Elevation of ground at well site 950 feet, mean sea level.  
(As near as known)

Depth to water table various feet.

7. Capacity of Well: 400 g.p.m. with 10 feet drawdown.

500 g.p.m. with 25 feet drawdown.

Date of test 1947

If Flowing Well: Measured discharge \_\_\_\_\_ g.p.m. on \_\_\_\_\_  
(Date)


Shut-in pressure at ground surface \_\_\_\_\_ lbs. per sq. in. on \_\_\_\_\_  
(Date)

Water is controlled by \_\_\_\_\_  
(Cap, valve, etc.)





Township 6 N Range 35 E W.M.  
North

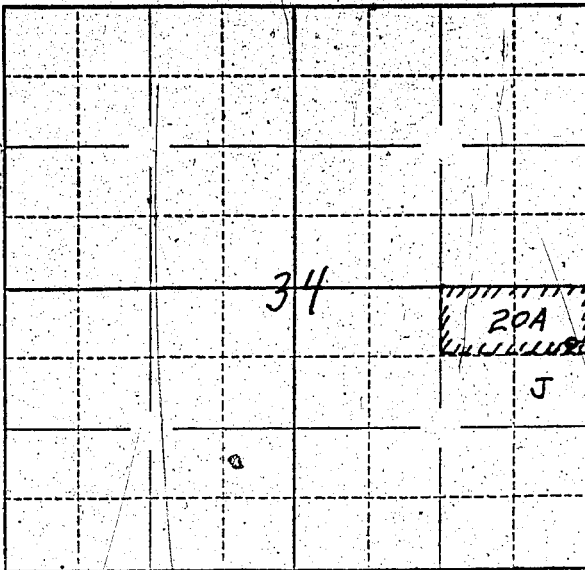

Location of Well  
650 ft. South-100 feet  
West of the E 1/4  
Corner of Sec 34

Locate well and acreage of irrigated land on plat.

Scale: ~~1/4~~ - 1 Mile  
4

STATE OF OREGON

County of Wasco

I, Fred S. Groth, being first duly sworn, do hereby certify that I have read the foregoing Registration Statement and that all of the items therein contained are true to the best of my knowledge and belief.

Fred S. Groth

(Signature of Registrant)

Subscribed and sworn to before me this 27 day of July, 1958.

My commission expires 6/24/59. Ed Fullerton

(Notary Public)

(SEAL)

**CERTIFICATE OF REGISTRATION**

STATE OF OREGON

County of Marlon

{ ss.

This is to certify that the foregoing Registration Statement was received in the office of the State Engineer on the 24th day of July, 1958, at 1:00 o'clock P. M. and has been duly recorded in said office in Book No. 11 of Registration Statements on page GR-2508

~~Construction shall be completed by 1959 and the well completed by 1959~~  
~~beneficial use by 1959~~

Witness my hand this 6th day of April, 1959.

Lewis A. Stanley

(State Engineer)

\$15.00

By

GR-2508

(Deputy)