

Registration Statement

OF CLAIMANT OF RIGHT TO APPROPRIATE GROUND WATER

TO THE STATE ENGINEER OF OREGON:

I, Glen D. Yarnell
of 5055 Herrin Road, Salem County of Marion
(Mailing address)

State of Oregon, do hereby make application for a certificate of registration as evidence of a right to appropriate ground water.

1. Source from which water is withdrawn is Pump Well
(Flowing well, pump well, infiltration trench, or tunnel)

2. Location is: 6 miles N.E. Salem
(Approximate distance and direction from nearest city or town)

and is more particularly described as follows:

(a) 19.7 chains West & 100' North from S.E. Corner J. Martin D.L. Co.
(Give distance and bearing to corner of section or other legal subdivision)

being within SE4 NW4 of Sec. 8 Twp. 7S Rge. 2W
(Smallest legal subdivision) (N. or S.) (E. or W.)

or (b) within limits of recorded platted property, town or city:

in Lot _____, Block _____ of _____
(Name of plat or addition)

(If within city or town, give name) County of _____

3. Construction Work was begun on Before 1949; was completed on Before 1949
(Date) (Date)

and the ground water claimed was first used for the purposes set out below on Before 1949
(Date)

since which time the water has been used Continuously
(Continuously or intermittently)

from Before 1949 to July 25, 1958
(Date) (Date)

4. Quantity of water claimed and used is 15 gallons per minute; 2.74 acre feet per year.

5. Purpose or Purposes for which water is used ~~Domestic~~ Irrigation

(Domestic, irrigation, municipal, manufacturing, industrial, etc.)

6. Description of Well: Depth 110 feet. Type Drilled
(Dug or drilled)

diameter 6 inches. Elevation of ground at well site _____ feet, mean sea level.

Depth to water table Unknown feet.
(As near as known)

7. Capacity of Well: No Test g.p.m. with _____ feet drawdown.

_____ g.p.m. with _____ feet drawdown.

Date of test _____

If Flowing Well: Measured discharge _____ g.p.m. on _____
(Date)

Shut-in pressure at ground surface _____ lbs. per sq. in. on _____
(Date)

Water is controlled by _____
(Cap, valve, etc.)

Size.)

..... inch diameter from to feet

Describe and show depth of shoe, plug, adapter, liner or other details: _____

9. Perforated Casings or Screens:

_____ from _____ to _____

ness and depth as indicated.)

[illegible]



Bottom width ft. Discharge g.p.m. Date of test

(Length, course, and cross sectional size)

(Make, type and size)

(Type and horsepower)

Township 7S Range 2W, W.M.
North

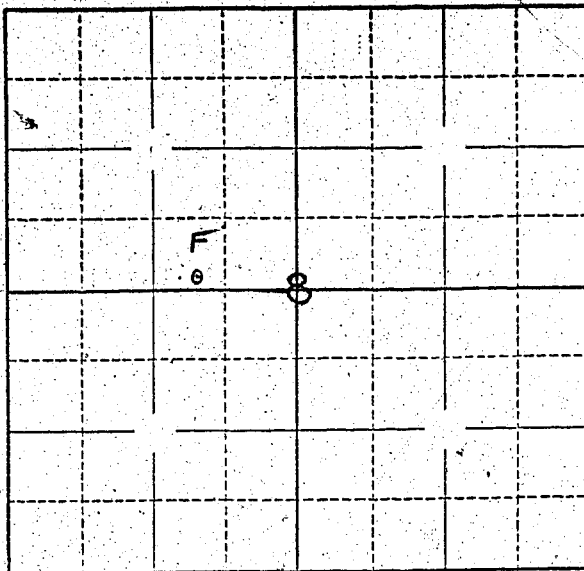

Locate well and acreage of irrigated land on plat.

Scale: $\frac{1}{4}$ " = 1 Mile

STATE OF OREGON

County of Marion

} ss.

I, Glen D. Yarnell, being first duly sworn, do hereby certify that I have read the foregoing Registration Statement and that all of the items therein contained are true to the best of my knowledge and belief.

Glen D. Yarnell
(Signature of Registrant)

Subscribed and sworn to before me this 24th day of July, 1955.

My commission expires July 22 1960

Carroll E. Wall
(Notary Public)

(SEAL)

CERTIFICATE OF REGISTRATION

STATE OF OREGON

County of Marion

} ss.

This is to certify that the foregoing Registration Statement was received in the office of the State Engineer on the 24th day of July, 1958, at 2:50 o'clock P.M. and has been duly recorded in said office in Book No. 11 of Registration Statements on page GR-2514

Witness my hand this 6th day of April, 1959

Lawrence A. Stanley
(State Engineer)

By

(Deputy)

GR - 2514

#15.00