

Registration No. GR 2653

Certificate No. GR 2515

Registration Statement

OF CLAIMANT OF RIGHT TO APPROPRIATE GROUND WATER

TO THE STATE ENGINEER OF OREGON:

I, George Gideon Stroz Sr.

of 4640 Portland Road, NE, Salem, County of Marion
(Mailing address)

State of Oregon, do hereby make application for a certificate of registration as evidence of a right to appropriate ground water.

1. Source from which water is withdrawn is pump well
(Flowing well, pump well, infiltration trench, or tunnel)

2. Location is: 1.2 miles north of Salem City Limits (Carlton Way) on 99E;
(Approximate distance and direction from nearest city or town)

and is more particularly described as follows:

(a) N. 3.30 ch. & W. 7.70 ch. from S.E. cor. Sec. 1 (apprx. calculations)
(Give distance and bearing to corner of section or other legal subdivision)

being within S.E. 1/4 S.E. 1/4 of Sec. 1, Twp. 7 S, Rge. 3 W
(Smallest legal subdivision) (S. or W.)

or (b) within limits of recorded platted property, town or city:

in Lot _____, Block _____ of _____
(Name of plat or addition)

County of _____
(If within city or town, give name)

3. Construction Work was begun on August 1937; was completed on August 1937
(Date) (Date)

and the ground water claimed was first used for the purposes set out below on August 1937
(Date)

since which time the water has been used continuously
(Continuously or intermittently)

from August 1937 to present
(Date) (Date)

4. Quantity of water claimed and used is 30 gallons per minute; 8 acre feet per year.

5. Purpose or Purposes for which water is used domestic and irrigation
(Domestic, irrigation, municipal, manufacturing, industrial, etc.)

6. Description of Well: Depth 85 feet. Type drilled
(Dug or drilled)

diameter 6 inches. Elevation of ground at well site 183 feet, mean sea level.
(As near as known)

Depth to water table apprx. 40 feet.

7. Capacity of Well: 1000 gal. per hour, without lowering water level.

_____ g.p.m. with _____ feet drawdown.
_____ g.p.m. with _____ feet drawdown.

Date of test August 1937

If Flowing Well: Measured discharge _____ g.p.m. on _____
(Date)

Shut-in pressure at ground surface _____ lbs. per sq. in. on _____
(Date)

Water is controlled by _____
(Cap, valve, etc.)

8. Casing: (Give diameter, commercial specifications and depth below ground surface of each casing size.)

6 inch diameter (steel casing) from surface to 85 feet
 inch diameter from to feet
 inch diameter from to feet
 inch diameter from to feet

Describe and show depth of shoe, plug, adapter, liner or other details: reservoir at bottom of 85 foot casing.

9. Perforated Casings or Screens:

None from 0 to
 (Number per foot and size of perforations, or describe screen)
 from to
 from to
 from to

10. Log of Well: (Describe each stratum or formation clearly, indicate if water bearing, and give thickness and depth as indicated.)

MATERIAL	Thickness (Feet)	Depth to Bottom (Feet)
from surface to approx. 58 feet--clay & soil		
from 58 feet to approx. 75 feet--water & sand		
from 75 feet to 85 feet & below--clean 3/4" to 1 1/2" water bearing gravel.		

If log of well is not available, give name and address of driller. J.A. Sneed & Sons, 2505 Brooks St. Salem, Oregon

Infiltration Trench: Covered or open

Dimensions: Length ft. Minimum depth ft. Maximum depth ft.

Bottom width ft. Discharge g.p.m. Date of test

Tunnel: Type of lining

Dimensions:

(Length, course, and cross sectional size)

Position of water bearing stratum with reference to portal of tunnel

Log of tunnel: (Preceding table for log of well may be used, if desired. Give footage from portal and character of materials, as pertinent.)

13. Pumping Equipment:

(a) Pump Advance, 1 1/2" pipe, 1 hp, jet type Capacity 30 g.p.m.
(Make, type and size)

(b) Motor 1 hp, electric
(Type and horsepower)


14. Location of area irrigated or to be irrigated, or place of use if for purposes other than irrigation.

Township North or South	Range E. or W. of Willamette Meridian	Section	Forty-acre Tract	Number Acres To Be Irrigated	Date of Reclamation
7 S	3 W	1	S.E. 1/4 S.E. 1/4	4.0 acres	1937

15. If the ground water supply is supplemental to an existing water supply, identification of any application for a permit, permit, certificate or adjudicated right to appropriate water made or held by the registrant.

None

Township 7 S Range 3 W, W.M.
North

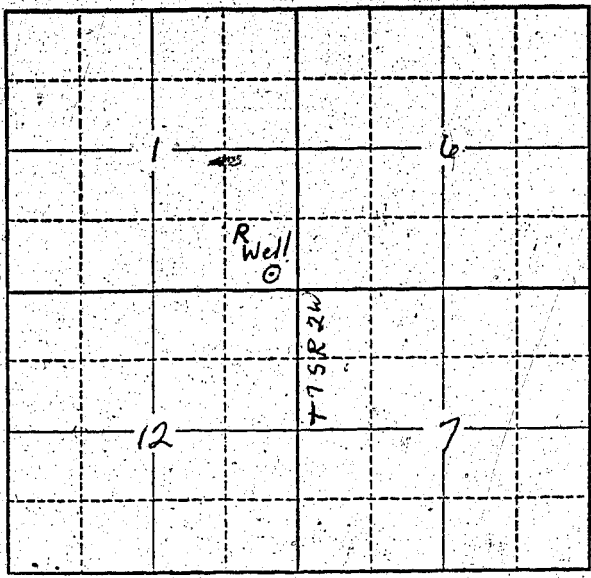

Locate well and acreage of irrigated land on plat.
Scale: 2" = 1 Mile

STATE OF OREGON }
County of MARION } ss.

I, GEORGE G. STROZT, being first duly sworn, do hereby certify that I have read the foregoing Registration Statement and that all of the items therein contained are true to the best of my knowledge and belief.

George G. Strozt
(Signature of Registrant)

Subscribed and sworn to before me this 24th day of JULY, 1958

My commission expires 1-30-59
Norma J. Epithe
(Notary Public)

(SEAL)

CERTIFICATE OF REGISTRATION

STATE OF OREGON }
County of Marion } ss.

This is to certify that the foregoing Registration Statement was received in the office of the State Engineer on the 24th day of July, 1958, at 10⁰⁰ o'clock A. M. and has been duly recorded in said office in Book No. 11 of Registration Statements on page GR-2515

Witness my hand this 6th day of April, 1959

Lewis A. Stanley
(State Engineer)

By _____
(Deputy)

#15.00