

Registration Statement

OF CLAIMANT OF RIGHT TO APPROPRIATE GROUND WATER

TO THE STATE ENGINEER OF OREGON:

I, Ralph M. Husted
of Box 178 Route 1 Turner County of Marion
(Mailing address)

State of Oregon, do hereby make application for a certificate of registration as evidence of a right to appropriate ground water.

1. Source from which water is withdrawn is Pump well
(Flowing well, pump well, infiltration trench, or tunnel)

2. Location is: Five miles west of Stayton
(Approximate distance and direction from nearest city or town)

and is more particularly described as follows:

(a) 180 feet west & 1200 feet south from NE corner Section 23
(Give distance and bearing to corner of section or other legal subdivision)

being within NE 1/4 of NE 1/4 of Sec. # 23, Twp. 9-5, Rge. 2-W
(Smallest legal subdivision) (S. or S.) (T. or T.) (R. or W.)

or (b) within limits of recorded platted property, town or city: _____

in Lot _____, Block _____ of _____
(Name of plat or addition)

County of _____
(If within city or town, give name)

3. Construction Work was begun on March 1954; was completed on April 1, 1954
(Date) (Date)

and the ground water claimed was first used for the purposes set out below on April 1954
(Date)

since which time the water has been used Irrigating Row Crops
(Continuously or intermittently)

from April 1954 to Oct. 1957
(Date) (Date)

4. Quantity of water claimed and used is 400 gallons per minute; _____ acre feet per year.

5. Purpose or Purposes for which water is used Irrigation
(Domestic, irrigation, municipal, manufacturing, industrial, etc.)

6. Description of Well: Depth 26 feet. Type Drilled
(Dug or drilled)

diameter 8 inches. Elevation of ground at well site _____ feet, mean sea level.
(As near as known)

Depth to water table 5 feet.

7. Capacity of Well: _____ g.p.m. with _____ feet drawdown. FULL CAP. UNKNOWN

400 g.p.m. with 3 feet drawdown. DURING Regular Irrigation


Date of test NONE

If Flowing Well: Measured discharge _____ g.p.m. on _____
(Date)

Shut-in pressure at ground surface _____ lbs. per sq. in. on _____
(Date)

Water is controlled by _____
(Cap, valve, etc.)

Township 9-S Range 2-W, W.M.
North

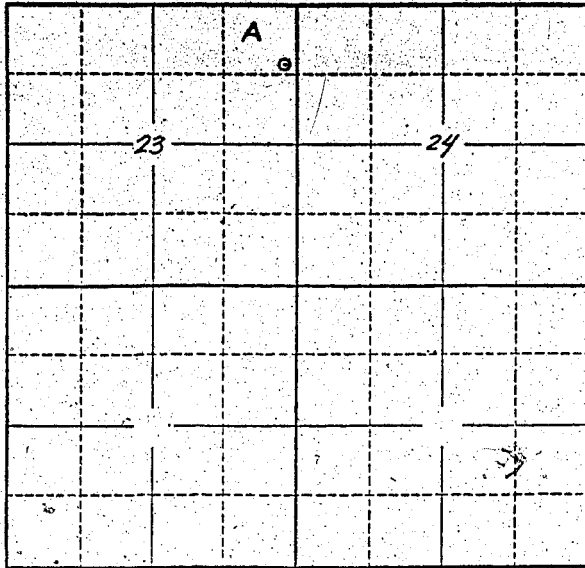

Locate well and acreage of irrigated land on plat.
Scale: 2" = 1 Mile

STATE OF OREGON

County of Marion } ss.

I Ralph Husted being first duly sworn, do hereby certify that I have read the foregoing Registration Statement and that all of the items therein contained are true to the best of my knowledge and belief.

Ralph Husted
(Signature of Registrant)

Subscribed and sworn to before me this 24th day of July, 1958

My commission expires 12th June 1961 Wm. S. Bartholomew
(Notary Public)

(SEAL)

CERTIFICATE OF REGISTRATION

STATE OF OREGON

County of Marion } ss.

This is to certify that the foregoing Registration Statement was received in the office of the State Engineer on the 24th day of July, 1958, at 3:40 o'clock P.M. and has been duly recorded in said office in Book No. 11 of Registration Statements on page GR-2517

Witness my hand this 6th day of April, 1959

Lewis U. Stanley
(State Engineer)

\$ 15.00

By _____ (Deputy)