

15 Rs

Registration No. GR 2660
Certificate No. GR 2522

Registration Statement

OF CLAIMANT OF RIGHT TO APPROPRIATE GROUND WATER

TO THE STATE ENGINEER OF OREGON:

I, Ray G. Arney
of Box 516 Woodburn County of Marion
(Mailing address)
State of Oregon, do hereby make application for a certificate of registration as evidence of a right to appropriate ground water.

- Source from which water is withdrawn is spring well #1
(Flowing well, pump well, infiltration trench, or tunnel)
- Location is: 1/4 mile N.W. of Woodburn
(Approximate distance and direction from nearest city or town)

and is more particularly described as follows:

(a) NORTH 700' & West 651' from the SE¹ Sec. Corner
between SEC. Corner between SE¹ of SW^{1/4} SECTIONS 1, 12
being within SE¹ of SW^{1/4} of Sec. 1, 12, Twp. 5 S., Rge. 2 W. W.M.
(Smallest legal subdivision) (N. or S.) (E. or W.)

or (b) within limits of recorded platted property, town or city:
in Lot _____, Block _____ of _____
(Name of plat or addition)
County of _____
(If within city or town, give name)

3. Construction Work was begun on Jan 1947; was completed on Jan 15 1947
(Date) (Date)

and the ground water claimed was first used for the purposes set out below on Jan 1947
since which time the water has been used Continuously
(Continuously or intermittently)
from May to Oct
(Date) (Date)

4. Quantity of water claimed and used is 50 + 10 gallons per minute; _____ acre feet per year.

5. Purpose or Purposes for which water is used
Irrigation
(Domestic, irrigation, municipal, manufacturing, industrial, etc.)

6. Description of Well: Depth 140 feet. Type drilled
(Dug or drilled)
diameter 6 inches. Elevation of ground at well site _____ feet, mean sea level.
(As near as known)
Depth to water table 15 feet.

7. Capacity of Well: 100 g.p.m. with 1.0 feet drawdown.
_____ g.p.m. with _____ feet drawdown.


Date of test Jan 15 1947

If Flowing Well: Measured discharge _____ g.p.m. on _____
(Date)

Shut-in pressure at ground surface _____ lbs. per sq. in. on _____
(Date)

Water is controlled by _____
(Csp. valve, etc.)

Township 55 Range 7W W.M.
North

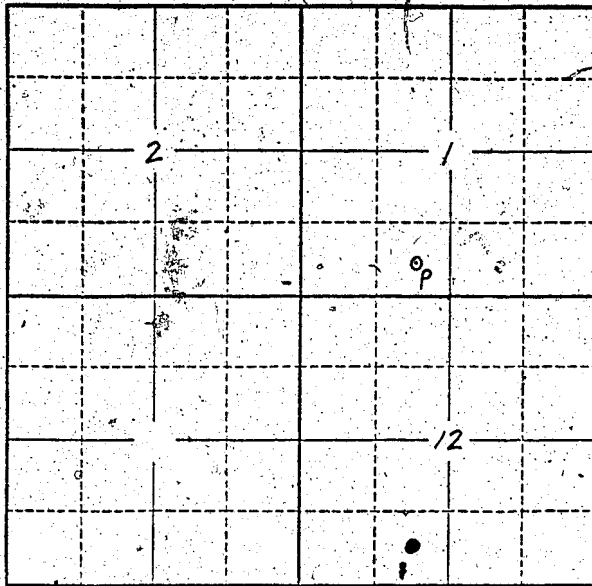

Locate well and acreage of irrigated land on plat.
Scale: 2" = 1 Mile

STATE OF OREGON

County of Marion } ss.

I, _____, being first duly sworn, do hereby certify that I have read the foregoing Registration Statement and that all of the items therein contained are true to the best of my knowledge and belief.

Roy E. Arney
(Signature of Registrant)

Subscribed and sworn to before me this 24th day of July, 1958.

My commission expires 12th July June 1961 Wm. S. Bartholomew
(Notary Public)

(SEAL)

CERTIFICATE OF REGISTRATION

STATE OF OREGON

County of Marion } ss.

This is to certify that the foregoing Registration Statement was received in the office of the State Engineer on the 24th day of July, 1958, at 4:30 o'clock P.M. and has been duly recorded in said office in Book No. 11 of Registration Statements on page GR 2522

Witness my hand this 6th day of April, 1959

Lewis A. Stanley
(State Engineer)

By _____
(Deputy)

#1545

GR - 2522