

17 25

Registration No. GR. 2661

Certificate No. GR. 2523

Registration Statement

OF CLAIMANT OF RIGHT TO APPROPRIATE GROUND WATER

TO THE STATE ENGINEER OF OREGON:

I, Roy G. Arley
of Box 516 Woodburn County of Marion
(Mailing address)
State of Oregon, do hereby make application for a certificate of registration as evidence of a right to appropriate ground water.

- 1. Source from which water is withdrawn is sump well #2
(Flowing well, pump well, infiltration trench, or tunnel)
- 2. Location is: 1/4 miles N.W. of Woodburn
(Approximate distance and direction from nearest city or town)

and is more particularly described as follows:

(a) NORTH 1465' & WEST 952' FROM THE SOUTH 1/4 COR.
(Give distance and bearing to corner of section or other legal subdivision)

being within N.W. 1/4 of the SE 1/4 of Sec. 1, Twp. 55, Rge. 2 W.
(Smallest legal subdivision) (N. or S.) (E. or W.)

or (b) within limits of recorded platted property, town or city:

in Lot _____ Block _____ of _____
(Name of plat or addition)
County of _____
(If within city or town, give name)

3. Construction Work was begun on August 21, 1953, was completed on August 22, 1953
(Date) (Date)

and the ground water claimed was first used for the purposes set out below on August 1953
(Date)

since which time the water has been used Continuously
(Continuously or intermittently)

from MAY to OCTOBER
(Date) (Date)

4. Quantity of water claimed and used is 80 + 20 gallons per minute; _____ acre feet per year.

5. Purpose or Purposes for which water is used exempt domestic and irrigation
(Domestic, irrigation, municipal, manufacturing, industrial, etc.)

6. Description of Well: Depth 145 feet. Type drilled
(Dug or drilled)

diameter 8 inches. Elevation of ground at well site _____ feet, mean sea level.
(As near as known)

Depth to water table 27 feet.

7. Capacity of Well: 180 g.p.m. with 60 feet drawdown.

_____ g.p.m. with _____ feet drawdown.

Date of test Aug. 1953

If Flowing Well: Measured discharge _____ g.p.m. on _____
(Date)

Shut-in pressure at ground surface _____ lbs. per sq. in. on _____
(Date)

Water is controlled by _____
(Cap, valve, etc.)

Also South 100' & East 6' from the most easterly
* S. E. cor. of the FRANCIS PLOURE D.L.C. NO 93

8. Casing: (Give diameter, commercial specifications and depth below ground surface of each casing size.)

..... inch diameter	from	to	feet
..... inch diameter	from	to	feet
..... inch diameter	from	to	feet
..... inch diameter	from	to	feet

Describe and show depth of shoe, plug, adapter, liner or other details:

.....

.....

9. Perforated Casings or Screens:

..... <small>(Number per foot and size of perforations, or describe screen)</small>	from	to
.....	from	to
.....	from	to
.....	from	to

10. Log of Well: (Describe each stratum or formation clearly, indicate if water bearing, and give thickness and depth as indicated.)

MATERIAL	Thickness (Feet)	Depth to Bottom (Feet)

If log of well is not available, give name and address of driller.

J. W. BECK, Conly

11. Infiltration Trench: Covered or open

Dimensions: Length _____ ft. Minimum depth _____ ft. Maximum depth _____ ft.
 Bottom width _____ ft. Discharge _____ g.p.m. Date of test _____

12. Tunnel: Type of lining

Dimensions: _____
(Length, course, and cross sectional size)
 Position of water bearing stratum with reference to portal of tunnel _____

Log of tunnel: (Preceding table for log of well may be used, if desired. Give footage from portal and character of materials, as pertinent.)

13. Pumping Equipment:

(a) Pump *SUMO Summerville* Capacity *90* g.p.m.
(Make, type, and size)


(b) Motor *3HP single phase and 1HP single phase set* *20 H.P.M.*
(Type and horsepower)

14. Location of area irrigated or to be irrigated, or place of use if for purposes other than irrigation.

Township North or South	Range E. or W. of Willamette Meridian	Section	Forty-acre Tract	Number Acres To Be Irrigated	Date of Reclamation
<i>T 5 S.</i>	<i>R 2 W</i>	<i>1</i>	<i>NW 1/4 SE 1/4</i>	<i>10.00</i>	<i>1953</i>
<i>"</i>	<i>"</i>	<i>"</i>	<i>SW 1/4 SE 1/4</i>	<i>34.55</i>	<i>"</i>
				<i>44.55 a</i>	<i>"</i>

15. If the ground water supply is supplemental to an existing water supply, identification of any application for a permit, permit, certificate or adjudicated right to appropriate water made or held by the registrant.

Township 55 Range 2W W.M.
North

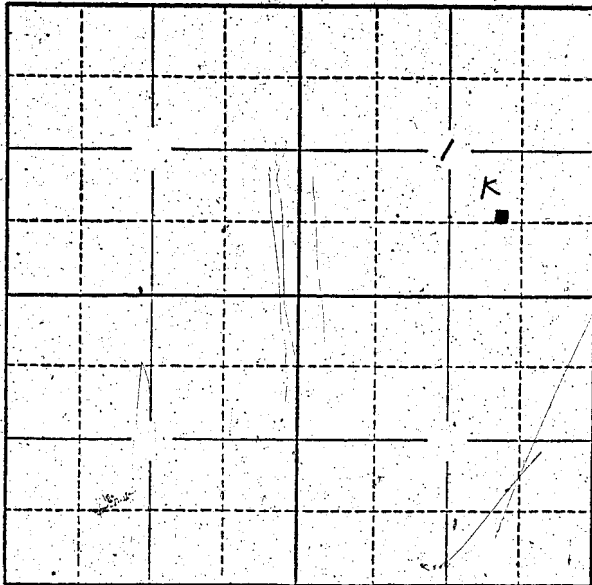

Locate well and acreage of irrigated land on plat.
Scale: 2" = 1 Mile

STATE OF OREGON

County of Marion } ss.

I, _____, being first duly sworn, do hereby certify that I have read the foregoing Registration Statement and that all of the items therein contained are true to the best of my knowledge and belief.

Roy E. Arney
(Signature of Registrant)

Subscribed and sworn to before me this 24th day of July, 1958

My commission expires 12th June 1961 Wm. S. Bartholomew
(Notary Public)

(SEAL)

CERTIFICATE OF REGISTRATION

STATE OF OREGON }
County of Marion } ss.

This is to certify that the foregoing Registration Statement was received in the office of the State Engineer on the 24th day of July, 1958, at 4:20 o'clock P. M. and has been duly recorded in said office in Book No. 11 of Registration Statements on page GR-2523

Witness my hand this 6th day of April, 1959

Lewis A. Stanley
(State Engineer)

By _____
(Deputy)

#17.25

GR - 2523