

Registration Statement

OF CLAIMANT OF RIGHT TO APPROPRIATE GROUND WATER

TO THE STATE ENGINEER OF OREGON,

I, Hans Danksen
of Route 1 Box #75 - Woodburn County of Marion
(Mailing address)

State of Oregon do hereby make application for a certificate of registration as evidence of a right to appropriate ground water.

1. Source from which water is withdrawn is Pump Well
(Flowing well, pump well, infiltration trench, or tunnel)
2. Location is: 1 mile North West of West Woodburn
(Approximate distance and direction from nearest city or town)

and is more particularly described as follows:

(a) 3 abs. S 1/4 ab. W from NE corner Dachesne D/C #8
(Give distance and bearing to corner of section or other legal subdivision)
being within SE 1/4 NE 1/4 of Sec. 3, Twp. 5 South Rge. 2 West
(Smallest legal subdivision) (N. or S.) (E. or W.)

or (b) within limits of recorded platted property, town or city:
in Lot _____, Block _____ of _____
(Name of plat or addition)
County of Marion
(If within city or town, give name)

3. Construction Work was begun on July 1951 was completed on Sept 5
(Date) (Date)

and the ground water claimed was first used for the purposes set out below on April 1952
(Date)
since which time the water has been used Each Summer
(Continuously or intermittently)
from April 1 to Oct. 30
(Date) (Date)

4. Quantity of water claimed and used is 315 gallons per minute; _____ acre feet per year.

5. Purpose or Purposes for which water is used Irrigating berries & Truck crops
(Domestic, irrigation, municipal, manufacturing, industrial, etc.)

6. Description of Well: Depth 126 feet. Type Drilled
(Dug or drilled)
diameter 12 inches. Elevation of ground at well site 145 feet, mean sea level.
(As near as known)
Depth to water table 18 feet.

7. Capacity of Well: 600 g.p.m. with 45 feet drawdown.
_____ g.p.m. with _____ feet drawdown.

Date of test 1952 Sept.

If Flowing Well: Measured discharge _____ g.p.m. on _____
(Date)

Shut-in pressure at ground surface _____ lbs. per sq. in. on _____
(Date)

Water is controlled by _____
(Cap, valve, etc.)

8. Casing: (Give diameter, commercial specifications and depth below ground surface of each casing size.)

10 inch diameter from 0 to 106 feet
 inch diameter from to feet
 inch diameter from to feet
 inch diameter from to feet

Describe and show depth of shoe, plug, adapter, liner or other details: *None*


9. Perforated Casings or Screens:

1/4 inch Wide 1 inch Long 20 per Foot from 92 to 106
(Number per foot and size of perforations, or describe screen)
 from to
 from to
 from to

10. Log of Well: (Describe each stratum or formation clearly, indicate if water bearing, and give thickness and depth as indicated.)

MATERIAL	Thickness (Feet)	Depth to Bottom (Feet)
<i>Brown Clay</i>	<i>0-18</i>	
<i>Brown Sand</i>	<i>18-23</i>	
<i>Blue Clay</i>	<i>23-95</i>	
<i>Black Sand</i>	<i>95-92</i>	
<i>Sand & Gravel</i>	<i>92-100</i>	
<i>Gravel</i>	<i>100-106</i>	
<i>Blue Clay</i>	<i>106-112</i>	<i>112</i>

Township 55 Range 2W, W.M.
North

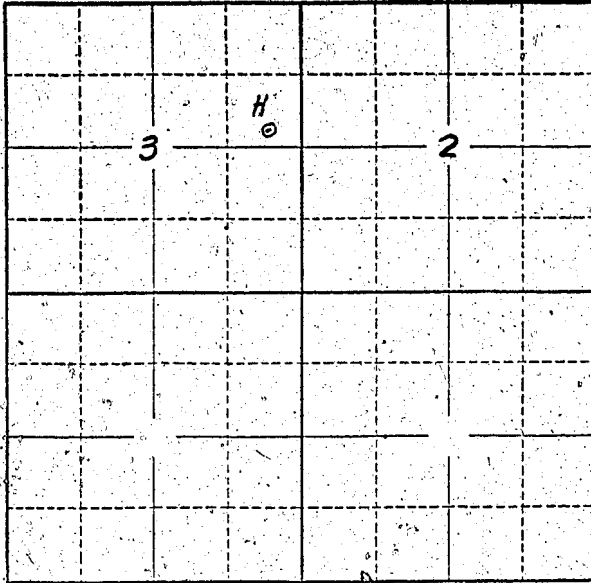

Locate well and acreage of irrigated land on plat.
Scale: 2" = 1 Mile

STATE OF OREGON

County of Marion } ss.

I, Anna Damskey being first duly sworn, do hereby certify that I have read the foregoing Registration Statement and that all of the items therein contained are true to the best of my knowledge and belief.

Anna Damskey
(Signature of Registrant)

Subscribed and sworn to before me this 25th day of July, 19 58

My commission expires 12th June 1961 Wm. S. Bartholomew
(Notary Public)

(SEAL)

CERTIFICATE OF REGISTRATION

STATE OF OREGON

County of Marion } ss.

This is to certify that the foregoing Registration Statement was received in the office of the State Engineer on the 25th day of July, 19 58, at 8:45 o'clock A. M. and has been duly recorded in said office in Book No. 11 of Registration Statements on page GR 2524

Witness my hand this 6th day of April, 19 59

Lewis A. Stanley
(State Engineer)

By _____ (Deputy)

#16.35

GR = 2524