

Registration No. GR 2663

Certificate No. GR 2525

Registration Statement

OF CLAIMANT OF RIGHT TO APPROPRIATE GROUND WATER

TO THE STATE ENGINEER OF OREGON:

I, W. Edgar Nafziger

of Rte. 2, box 536 Salem County of Marien

State of Oregon, do hereby make application for a certificate of registration as evidence of a right to appropriate ground water.

1. Source from which water is withdrawn is Pump Well
(Flowing well, pump well, infiltration trench, or tunnel)

2. Location is: + 1 mile west of Central Howell
(Approximate distance and direction from nearest city or town)

and is more particularly described as follows:

(a) East 1403' ± North 150' from N. sec. cor. between 2 & 3
(Give distance and bearing to corner of section or other legal subdivision)

being within S.E. 1/4 of N.W. 1/4 of Sec. 2 Twp. 7S Rge. 2W
(Smallest legal subdivision) (N. or S.) (E. or W.)

or (b) within limits of recorded platted property, town or city:

in Lot _____, Block _____ of _____
(Name of plat or addition)

County of _____
(If within city or town, give name)

3. Construction Work was begun on Aug. 10, 1951; was completed on Aug. 24, 1951
(Date) (Date)

and the ground water claimed was first used for the purposes set out below on June 1951
(Date)

since which time the water has been used intermittently
(Continuously or intermittently)

from May to October
(Date) (Date)

4. Quantity of water claimed and used is 225 gallons per minute; 38 acre feet per year.

5. Purpose or Purposes for which water is used irrigation

(Domestic, irrigation, municipal, manufacturing, industrial, etc.)

6. Description of Well: Depth 139 feet, Type drilled
(Dug or drilled)

diameter 10 inches. Elevation of ground at well site 200 feet, mean sea level.
(As near as known)

Depth to water table 30 1/2 feet. in 1953

7. Capacity of Well: 300 g.p.m. with 55 1/2 feet drawdown.

200 g.p.m. with 35 1/2 feet drawdown.

Date of test May 21, 1953

If Flowing Well: Measured discharge _____ g.p.m. on _____
(Date)

Shut-in pressure at ground surface _____ lbs. per sq. in. on _____
(Date)

Water is controlled by _____
(Cap, valve, etc.)

8. Casing: (Give diameter, commercial specifications and depth below ground surface of each casing size.)

1.0 inch diameter from 0 to 139 feet
 inch diameter from to feet
 inch diameter from to feet
 inch diameter from to feet

Describe and show depth of shoe, plug, adapter, liner or other details:

9. Perforated Casings or Screens:

4 perforations every 2 feet from 90' to 139'
(Number per foot and size of perforations, or describe screen)
 from to
 from to
 from to

10. Log of Well: (Describe each stratum or formation clearly, indicate if water bearing, and give thickness and depth as indicated.)

MATERIAL	Thickness (Feet)	Depth to Bottom (Feet)
Dirt and quick sand	20	20
Blue clay	50	70
Yellow Sand	10	80
Cement gravel	8	88
Water gravel	7	95
Sand and gravel	12	107
Loose gravel	3	110
Water gravel	10	120
Cement gravel	10	130
Hard pan clay	9	139

If log of well is not available, give name and address of driller.

11. Infiltration Trench: Covered or open

Dimensions: Length _____ ft. Minimum depth _____ ft. Maximum depth _____ ft.
 Bottom width _____ ft. Discharge _____ g.p.m. Date of test _____

12. Tunnel: Type of lining

Dimensions: _____
(Length, course, and cross sectional size)

Position of water bearing stratum with reference to portal of tunnel

Log of tunnel: (Preceding table for log of well may be used, if desired. Give footage from portal and character of materials, as pertinent.)

13. Pumping Equipment:

- (a) Pump Barkley turbine, 8" 2 stage bowl assembly Capacity 22.5 g.p.m.
(Make, type and size)
- (b) Motor G.E. type K, 15 HP, 220 V, 3 phase
(Type and horsepower)


14. Location of area irrigated or to be irrigated, or place of use if for purposes other than irrigation.

Township North or South	Range E. or W. of Willamette Meridian	Section	Forty-acre Tract	Number Acres To Be Irrigated	Date of Reclamation
T. 7S	R. 2W	2	N.W. 1/4 of N.W. 1/4	0.22	1951
T. 7S	R. 2W	2	N.E. 1/4 of N.W. 1/4	12.94	1951
T. 7S	R. 2W	2	S.W. 1/4 of N.W. 1/4	2.07	1951
T. 7S	R. 2W	2	S.E. 1/4 of N.W. 1/4	29.38	1951
Total				44.61 acreage	

15. If the ground water supply is supplemental to an existing water supply, identification of any application for a permit, permit, certificate or adjudicated right to appropriate water made or held by the registrant.

None

Township 7S Range 2W W.M.
North

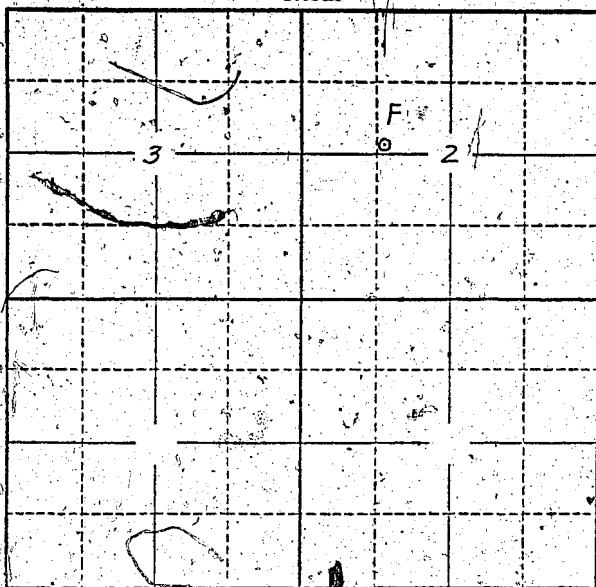

Locate well and acreage of irrigated land on plat.
Scale: 2" = 1 Mile

STATE OF OREGON

County of Marion } ss.

I, W. Edgar Nafziger, being first duly sworn, do hereby certify that I have read the foregoing Registration Statement and that all of the items therein contained are true to the best of my knowledge and belief.

W. Edgar Nafziger
(Signature of Registrant)

Subscribed and sworn to before me this 25th day of July, 1958

My commission expires 12th June 1961 Wm. S. Bartholomew
(Notary Public)

(SEAL)

CERTIFICATE OF REGISTRATION

STATE OF OREGON

County of Marion } ss.

This is to certify that the foregoing Registration Statement was received in the office of the State Engineer on the 25th day of July, 1958, at 9:30 o'clock A. M. and has been duly recorded in said office in Book No. 11 of Registration Statements on page GR-2525

Witness my hand this 6th day of April, 1959.
Lewis A. Stanley
(State Engineer)

By _____
(Deputy)

GR - 2525

17.25