






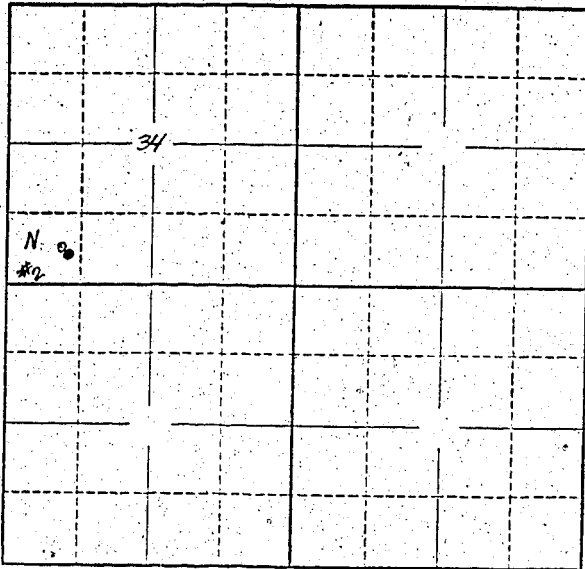

Township 1N Range 1E, W.M.  
North



Locate well and acreage of irrigated land on plat.  
Scale: 2" = 1 Mile

STATE OF OREGON

County of MULTNOMAH } ss.

I, RALPH H. CAKE, being first duly sworn, do hereby certify that I have read the foregoing Registration Statement and that all of the items therein contained are true to the best of my knowledge and belief.

Ralph H. Cake  
(Signature of Registrant)

Subscribed and sworn to before me this        day of July, 1958.

My commission expires Nov. 3, 1959  
(Notary Public)

(SEAL)

**CERTIFICATE OF REGISTRATION**

STATE OF OREGON }  
County of Marion } ss.

This is to certify that the foregoing Registration Statement was received in the office of the State Engineer on the 25<sup>th</sup> day of July, 1958, at 5:00 o'clock A.M. and has been duly recorded in said office in Book No. 11 of Registration Statements on page GR-2608

Witness my hand this 6<sup>th</sup> day of April, 1959.

# 22-00

Walter H. [Signature]  
(State Engineer)

By         
(Deputy)