

RECEIVED
JUL 28 1938
STATE ENGINEER
SALEM, OREGON

Registration No. GR-2676
Certificate No. GR-2147

Registration Statement

OF CLAIMANT OF RIGHT TO APPROPRIATE GROUND WATER

TO THE STATE ENGINEER OF OREGON:

I, Max W. Sullivan

of 1219 S. W. Park, Portland 5 County of Multnomah
(Mailing address)

State of Oregon, do hereby make application for a certificate of registration as evidence of a right to appropriate ground water.

1. Source from which water is withdrawn is Pump well
(Flowing well, pump well, infiltration trench, or tunnel)

2. Location is: At SW Tenth Ave. and Jefferson St., Portland, Oregon
(Approximate distance and direction from nearest city or town)

and is more particularly described as follows:

(a) 1200 feet south & 400 feet west from NE corner Section 4
(Give distance and bearing to corner of section or other legal subdivision)

being within NE 1/4 of NE 1/4 of Sec. 4, Twp. 15, Rge. 1E
(Smallest legal subdivision) (N. or S.) (E. or W.)

or (b) within limits of recorded platted property, town or city: Block 223 (all)

in Lot _____, Block 223 of 30 ft. North & 5 ft. east of SW corner of block
(Name of plat or addition)

Portland County of Multnomah Co.
(If within city or town, give name)

3. Construction Work was begun on Sept. 1938; was completed on Oct. 11, 1938
(Date) (Date)

and the ground water claimed was first used for the purposes set out below on approx. Jan. 1939
(Date)

since which time the water has been used intermittently as required for space cooling.
(Continuously or intermittently)

from Jan. 1939 to present date.
(Date) (Date)

4. Quantity of water claimed and used is 200 gallons per minute; _____ acre feet per year.

5. Purpose or Purposes for which water is used Air-conditioning the Hirsch Wing of the Portland Art Museum.
(Domestic, irrigation, municipal, manufacturing, industrial, etc.)

6. Description of Well: Depth 235 feet. Type drilled
(Dug or drilled)

diameter 10 inches. Elevation of ground at well site 124.5 feet, mean sea level.
(As near as known)

Depth to water table 110 feet.

7. Capacity of Well: 190 g.p.m. with 33 feet drawdown.

_____ g.p.m. with _____ feet drawdown.


Date of test Oct. 10 and 11, 1938

If Flowing Well: Measured discharge _____ g.p.m. on _____
(Date)

Shut-in pressure at ground surface _____ lbs. per sq. in. on _____
(Date)

Water is controlled by _____
(Cap, valve, etc.)

Township 15 Range 1E, W.M.
North

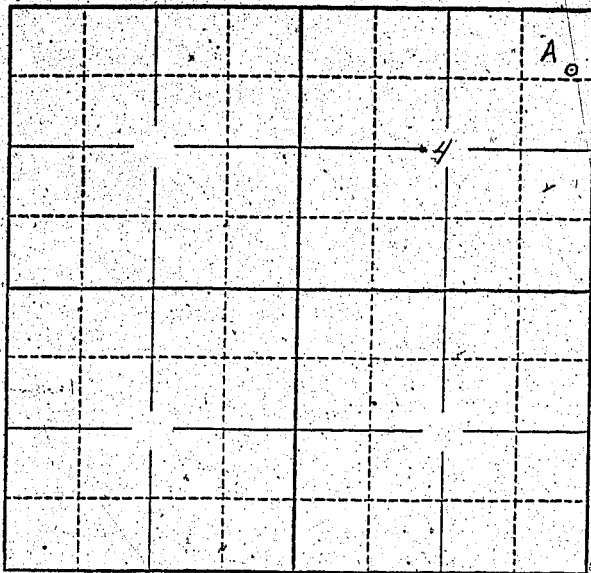

Locate well and acreage of irrigated land on plat.
Scale: 2" = 1 Mile

STATE OF OREGON

County of Multnomah } ss.

I, Max W. Sullivan, being first duly sworn, do hereby certify that I have read the foregoing Registration Statement and that all of the items therein contained are true to the best of my knowledge and belief.

Max W. Sullivan
(Signature of Registrant)

Subscribed and sworn to before me this 24th day of July, 1958.

My commission expires NOTARY PUBLIC FOR OREGON
MY COMMISSION EXPIRES MAY 19, 1952

Dora Coker
(Notary Public)

(SEAL)

CERTIFICATE OF REGISTRATION

STATE OF OREGON

County of Marion } ss.

This is to certify that the foregoing Registration Statement was received in the office of the State Engineer on the 25th day of July, 1958, at 8:00 o'clock A. M. and has been duly recorded in said office in Book No. 9 of Registration Statements on page GR 2147.

Witness my hand this 10th day of March, 1959

Leura A. Stanley
(State Engineer)

\$ 20.00

By _____
(Deputy)