

Registration Statement

OF CLAIMANT OF RIGHT TO APPROPRIATE GROUND WATER

TO THE STATE ENGINEER OF OREGON:

I, John E. Mook
of 2100 S.W. 185th Aloha County of Washington
(Mailing address)

State of _____, do hereby make application for a certificate of registration as evidence of a right to appropriate ground water.

- Source from which water is withdrawn is pump well
(Flowing well, pump well, infiltration trench, or tunnel)
- Location is: 7/10 mile North of Aloha, Oregon
(Approximate distance and direction from nearest city or town)

and is more particularly described as follows:

(a) S 20° 5' E 640' From N.W. Cor. Sec 7 to Well.
(Give distance and bearing to corner of section or other legal subdivision)
being within NW 1/4 NW 1/4 of Sec. E 7, Twp. 15, Rge. 1 W
(Smallest legal subdivision) (N. or S.) (E. or W.)

or (b) within limits of recorded platted property, town or city:

in Lot _____, Block _____ of _____
(Name of plat or addition)
County of Washington
(If within city or town, give name)

3. Construction Work was begun on 1945; was completed on 1945
(Date) (Date)

and the ground water claimed was first used for the purposes set out below on Aug 1945
(Date)

since which time the water has been used Continuously
(Continuously or intermittently)

from 1945 to 1950
(Date) (Date)

4. Quantity of water claimed and used is 50 gallons per minute; _____ acre feet per year.

5. Purpose or Purposes for which water is used ~~Domestic and~~ irrigation
(Domestic, irrigation, municipal, manufacturing, industrial, etc.)

6. Description of Well: Depth 90 feet. Type drilled
(Dug or drilled)
diameter 6 inches. Elevation of ground at well site 172 feet, mean sea level.
(As near as known)

Depth to water table 5 feet.

7. Capacity of Well: 300 g.p.m. with Estimated 75 feet drawdown.
_____ g.p.m. with _____ feet drawdown.


Date of test 1945

If Flowing Well: Measured discharge _____ g.p.m. on _____
(Date)

Shut-in pressure at ground surface None lbs. per sq. in. on _____
(Date)

Water is controlled by _____
(Cap, valve, etc.)

Township 15 Range 1W W.M.
North

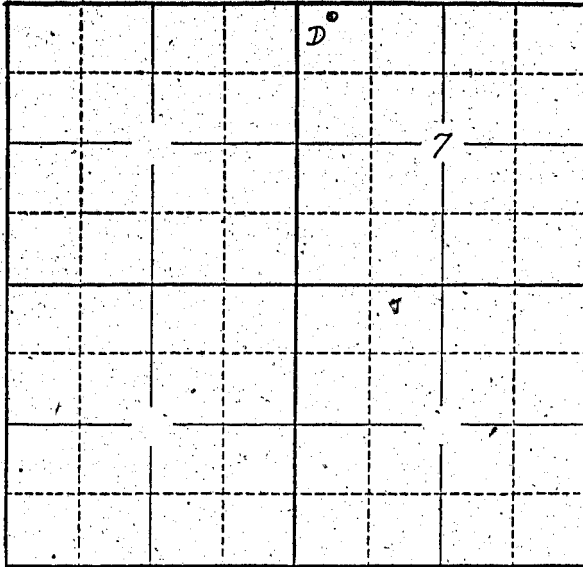

Locate well and acreage of irrigated land on plat.
Scale: 2" = 1 Mile

STATE OF OREGON

County of Washington } ss.

I, John E. Meeke being first duly sworn, do hereby certify that I have read the foregoing Registration Statement and that all of the items therein contained are true to the best of my knowledge and belief.

John E. Meeke
(Signature of Registrant)

Subscribed and sworn to before me this 9th day of July, 1958

My commission expires 10/24/60 Michael Cap
(Notary Public)

(SEAL)

CERTIFICATE OF REGISTRATION

STATE OF OREGON } ss.
County of Marion

This is to certify that the foregoing Registration Statement was received in the office of the State Engineer on the 25th day of July, 1958, at 8.00 o'clock A. M. and has been duly recorded in said office in Book No. 11 of Registration Statements on page GR-2540

Witness my hand this 6th day of April, 1959.

Lewis A. Stanley
(State Engineer)

By _____
(Deputy)

\$15.00