

Registration Statement

OF CLAIMANT OF RIGHT TO APPROPRIATE GROUND WATER

TO THE STATE ENGINEER OF OREGON:

I, Gustav Arnald Rick

of Route 1, Box 110-D Portland 9 County of Multnomah
(Mailing address)

State of Oregon, do hereby make application for a certificate of registration as evidence of a right to appropriate ground water.

1. Source from which water is withdrawn is pump well
(Flowing well, pump well, infiltration trench, or tunnel)

2. Location is: approximately 3 1/2 miles north of the community of Linnton in Portland;
(Approximate distance and direction from nearest city or town)

and is more particularly described as follows:

(a) 25' northeasterly and 240' northwesterly of most southerly corner of Lot 5, Morgan's Island Acres which well point is 945' west and 270' south of the east quarter corner of Section 17 and is a part of the NE 1/4 of the SE 1/4 of the section being within NE 1/4 of the SE 1/4 of Sec. 17, Twp. 2N, Rge. 1W
(Smallest legal subdivision) (N. or S.) (E. or W.)

or (b) within limits of recorded platted property, town or city:

in Lot 5, Block - of Morgan's Island Acres located on Sauvies Island
(Name of plat or addition)
County of Multnomah
(If within city or town, give name)

3. Construction Work was begun on May 1955; was completed on May 1955
(Date) (Date)

and the ground water claimed was first used for the purposes set out below on May 1955
(Date)

since which time the water has been used continuously
(Continuously or Intermittently)

from May 1955 to Present time
(Date) (Date)

4. Quantity of water claimed and used is 300 25 gallons per minute; 12 acre feet per year.

5. Purpose or Purposes for which water is used except household use and irrigation
(Domestic, irrigation, municipal, manufacturing, industrial, etc.)

6. Description of Well: Depth 84 feet. Type drilled
(Dug or drilled)

diameter 6 inches. Elevation of ground at well site approx. 42 feet, mean sea level.
(As near as known)

Depth to water table 32 feet.

7. Capacity of Well: 25 g.p.m. with unknown feet drawdown. well driller could not get bailer into and out of well fast enough to draw it down. I have pumped at full capacity of my pump for eight hours and head remained constant
g.p.m. with _____ feet drawdown.

Date of test May 1955


If Flowing Well: Measured discharge _____ g.p.m. on _____
(Date)

Shut-in pressure at ground surface _____ lbs. per sq. in. on _____
(Date)

Water is controlled by _____
(Cap, valve, etc.)

PLOT PLAN SHOWING LOCATION OF WELL ATTACHED

Township 2N Range 1W, W.M.
North

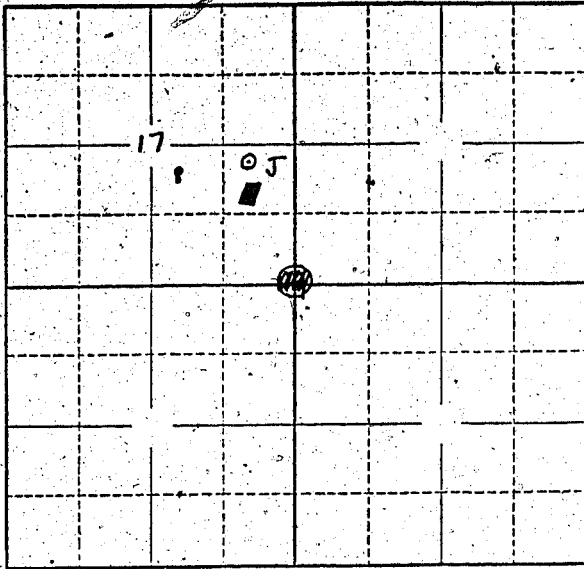

Locate well and acreage of irrigated land on plat.
Scale: 2" = 1 Mile

STATE OF OREGON }
County of Multnomah } ss.

I, Gustav Arnold Rick, being first duly sworn, do hereby certify that I have read the foregoing Registration Statement and that all of the items therein contained are true to the best of my knowledge and belief.

Gustav Arnold Rick
(Signature of Registrant)

Subscribed and sworn to before me this 24 day of July, 1958.

My commission expires Oct. 30, 1961
Helen C. Cannon
(Notary Public)

(SEAL)

CERTIFICATE OF REGISTRATION

STATE OF OREGON }
County of Marion } ss.

This is to certify that the foregoing Registration Statement was received in the office of the State Engineer on the 25th day of July, 1958, at 8.00 o'clock A. M. and has been duly recorded in said office in Book No. 11 of Registration Statements on page GR-2541.

Witness my hand this 6th day of April, 1959.

Lewis A. Stanley
(State Engineer)

By _____
(Deputy)

1500

GR - 2541