

Registration Statement

OF CLAIMANT OF RIGHT TO APPROPRIATE GROUND WATER

TO THE STATE ENGINEER OF OREGON:

I, Herschel R. Driever

of Aurora, Oregon Rt. 1, Box 218 County of Marion

State of Oregon, do hereby make application for a certificate of registration as evidence of a right to appropriate ground water.

1. Source from which water is withdrawn is Drilled or Pump Well

2. Location is: 1 1/2 miles West of Donald Oregon

and is more particularly described as follows:

(a) 660 H South E 265 East N. W. corn. Sec. 18

being within N. W. 1/4 N. W. 1/4 of Sec. 18, Twp. 4 S, Rge. 1 W

or (b) within limits of recorded platted property, town or city:

in Lot _____, Block _____ of _____

County of _____

3. Construction Work was begun on June 8, 1952; was completed on June 14, 1952

and the ground water claimed was first used for the purposes set out below on July 1, 1952

since which time the water has been used during irrigation season

from 1952 to Present

4. Quantity of water claimed and used is 180 gallons per minute; 30 acre feet per year.

5. Purpose or Purposes for which water is used Irrigation

6. Description of Well: Depth 92 feet. Type Drilled

diameter 10 inches. Elevation of ground at well site 150 feet, mean sea level.

Depth to water table 3 feet.

7. Capacity of Well: 180 g.p.m. with ? feet drawdown.

? g.p.m. with ? feet drawdown.

Date of test June 14th 1952


If Flowing Well: Measured discharge _____ g.p.m. on _____

Shut-in pressure at ground surface _____ lbs. per sq. in. on _____

Water is controlled by _____

Township 4S Range 1W, W.M.

North

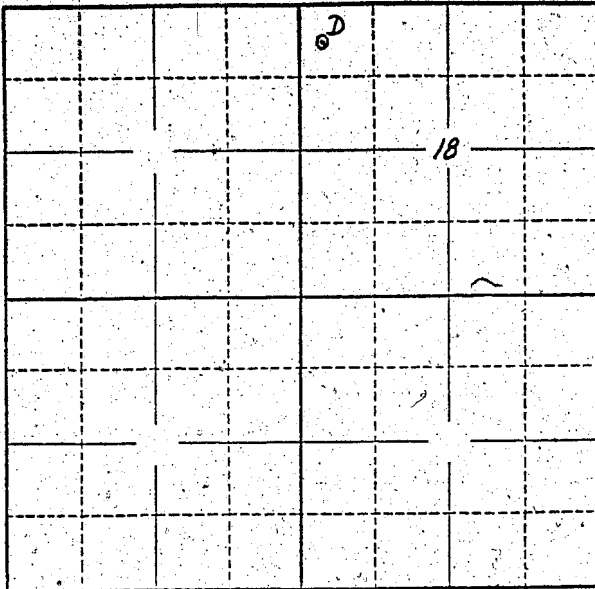

Locate well and acreage of irrigated land on plat.

Scale: 2" = 1 Mile

STATE OF OREGON

County of Marion } ss.

I, Herschel R. Driever, being first duly sworn, do hereby certify that I have read the foregoing Registration Statement and that all of the items therein contained are true to the best of my knowledge and belief.

Herschel R. Driever
(Signature of Registrant)

Subscribed and sworn to before me this 24th day of July, 1958

My commission expires Dec. 15, 1960

John M. Rasmussen
(Notary Public)

(SEAL)

CERTIFICATE OF REGISTRATION

STATE OF OREGON

County of Marion } ss.

This is to certify that the foregoing Registration Statement was received in the office of the State Engineer on the 25 day of July, 1958, at 8:00 o'clock A.M. and has been duly recorded in said office in Book No. 11 of Registration Statements on page GR-2545

Witness my hand this 6th day of April, 1959

Lewis A. Stanley
(State Engineer)

\$ 22.65

By _____ (Deputy)

GR - 2545