

Registration Statement

OF CLAIMANT OF RIGHT TO APPROPRIATE GROUND WATER

TO THE STATE ENGINEER OF OREGON:

I, Walter L. Sewell Sr. and/or Kathryn L. J. Sewell

of 5202 Table Rock Road, Central Point, County of Jackson

State of Oregon, do hereby make application for a certificate of registration as evidence of a right to appropriate ground water.

1. Source from which water is withdrawn is a SUMP
(Flowing well, pump well, infiltration trench, or tunnel)

2. Location is: approximately three(3) miles east of Central Point, Oregon
(Approximate distance and direction from nearest city or town)

and is more particularly described as follows:

(a) 1170 feet north and 540 feet east from the S $\frac{1}{4}$ corner Sec. 36
(Give distance and bearing to corner of section or other legal subdivision)

being within NW $\frac{1}{4}$ SW $\frac{1}{4}$ SE $\frac{1}{4}$ of Sec. 36, Twp. 36 S., Rge. 2 W.
(Smallest legal subdivision) (N. or S.) (E. or W.)

or (b) within limits of recorded platted property, town or city:

in Lot _____, Block _____ of _____
(Name of plat or addition)

County of _____
(If within city or town, give name)

3. Construction Work was begun on Apr. 27, 1952; was completed on May 2, 1952
(Date) (Date)

and the ground water claimed was first used for the purposes set out below on May 8, 1952
(Date)

since which time the water has been used each year continuously
(Continuously or intermittently)

from May 8, 1952 thru present
(Date) (Date)

4. Quantity of water claimed and used is 50 gallons per minute; 32 acre feet per year.

5. Purpose or Purposes for which water is used irrigation

(Domestic, irrigation, municipal, manufacturing, industrial, etc.)

6. Description of Sump: Depth app. 20 feet. Type Sump Dug
(Dug or drilled)

diameter 40' x 80' ~~inches~~. Elevation of ground at well site 1310 feet, mean sea level.
(As near as known)

Depth to water table 1.0 feet.

7. Capacity of Well: _____ g.p.m. with _____ feet drawdown.

_____ g.p.m. with _____ feet drawdown.


Date of test _____

If Flowing Well: Measured discharge _____ g.p.m. on _____
(Date)

Shut-in pressure at ground surface _____ lbs. per sq. in. on _____
(Date)

Water is controlled by _____
(Cap, valve, etc.)

Township 36 S. Range 2 W., W.M.
North

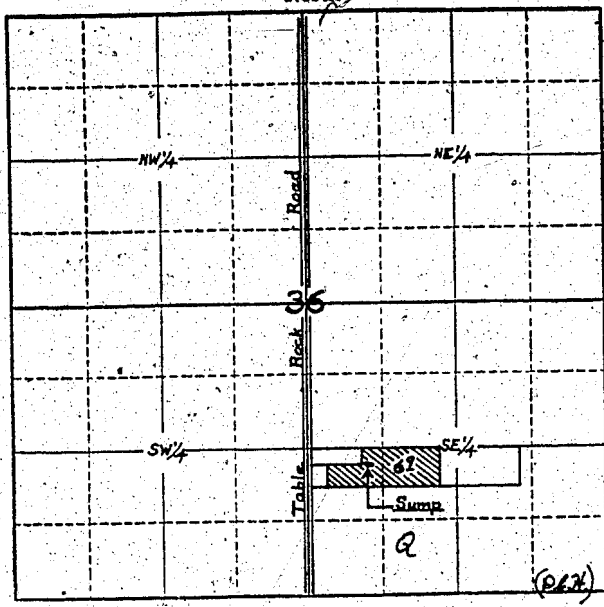

Locate well and acreage of irrigated land on plat.
Scale: 4" = 1 Mile

STATE OF OREGON

County of Jackson } ss.

I, Walter L. Sewell Sr. and/or Kathryn L. Sewell, being first duly sworn, do hereby certify that I have read the foregoing Registration Statement and that all of the items therein contained are true to the best of my knowledge and belief.

Walter L. Sewell Sr.
Kathryn L. Sewell
(Signature of Registrant)

Subscribed and sworn to before me this 23rd day of June, 1958

My commission expires My Commission Expires Feb. 9, 1962 C. L. ...
(Notary Public)

(SEAL)

CERTIFICATE OF REGISTRATION

STATE OF OREGON

County of Marion } ss.

This is to certify that the foregoing Registration Statement was received in the office of the State Engineer on the 25th day of July, 1958, at 8:00 o'clock A. M. and has been duly recorded in said office in Book No. 11 of Registration Statements on page GR-2549.

Witness my hand this 6th day of April, 1959

Clara A. Stanley
(State Engineer)

By _____ (Deputy)

\$1500

GR - 2549