

# Registration Statement

## OF CLAIMANT OF RIGHT TO APPROPRIATE GROUND WATER

TO THE STATE ENGINEER OF OREGON:

I, H.W. Ray  
of Rt 1 Box 372 Hillsboro County of Washington  
(Mailing address)

State of Oregon, do hereby make application for a certificate of registration as evidence of a right to appropriate ground water.

1. Source from which water is withdrawn is Pump well #1  
(Flowing well, pump well, infiltration trench, or tunnel)

2. Location is: 3 miles East on Cornell Rd.  
(Approximate distance and direction from nearest city or town)

and is more particularly described as follows:

(a) S 13° W 1500 feet from N 1/4 corner Section 34  
(Give distance and bearing to corner of section or other legal subdivision)  
being within SE 1/4 of NW 1/4 of Sec. 34, Twp. 1N, Rge. 3W  
(Smallest legal subdivision) (N., S., E., or W.)

or (b) within limits of recorded platted property, town or city:

in Lot \_\_\_\_\_, Block \_\_\_\_\_ of \_\_\_\_\_  
(Name of plat or addition)

County of \_\_\_\_\_  
(If within city or town, give name)

3. Construction Work was begun on 1936; was completed on 1936  
(Date) (Date)

and the ground water claimed was first used for the purposes set out below on 1936  
(Date)

since which time the water has been used Continuously through irrigation season  
(Continuously or intermittently)

from 1936 to 1958  
(Date) (Date)

4. Quantity of water claimed and used is 30 gallons per minute; 7 1/2 acre feet per year.

5. Purpose or Purposes for which water is used Irrigation

(Domestic, irrigation, municipal, manufacturing, industrial, etc.)

6. Description of Well: Depth 28 feet. Type Aug  
(Dug or drilled)

diameter 14 1/2 inches. Elevation of ground at well site \_\_\_\_\_ feet, mean sea level.  
(As near as known)

Depth to water table 10 feet.

7. Capacity of Well: 30 g.p.m. with 18 feet drawdown.

\_\_\_\_\_ g.p.m. with \_\_\_\_\_ feet drawdown.

Date of test 1957

If Flowing Well: Measured discharge \_\_\_\_\_ g.p.m. on \_\_\_\_\_  
(Date)


Shut-in pressure at ground surface \_\_\_\_\_ lbs. per sq. in. on \_\_\_\_\_  
(Date)

Water is controlled by \_\_\_\_\_  
(Cap, valve, etc.)





Township 1N Range 2W W.M.  
North

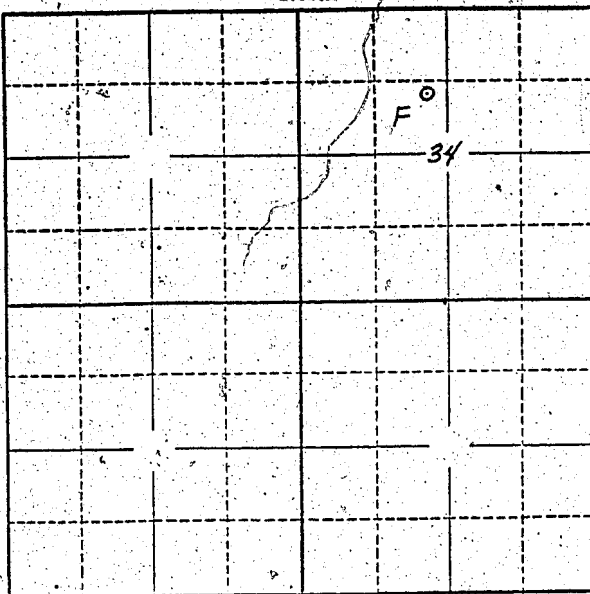

Locate well and acreage of irrigated land on plat.  
Scale: 2" = 1 Mile

STATE OF OREGON

County of Marion } ss.

I, \_\_\_\_\_, being first duly sworn, do hereby certify that I have read the foregoing Registration Statement and that all of the items therein contained are true to the best of my knowledge and belief.

H. W. Rany  
(Signature of Registrant)

Subscribed and sworn to before me this 26th day of March, 1958

My commission expires 12th June 1961

Wm. S. Bartholomew  
(Notary Public)

(SEAL)

### CERTIFICATE OF REGISTRATION

STATE OF OREGON

County of Marion } ss.

This is to certify that the foregoing Registration Statement was received in the office of the State Engineer on the 25 day of July, 1958, at 8:00 o'clock A. M. and has been duly recorded in said office in Book No. 11 of Registration Statements on page GR 2551

Witness my hand this 6th day of April, 1959

LEWIS A. Stanley  
(State Engineer)

By \_\_\_\_\_

(Deputy)

\$15.00

GR-2551