

Registration Statement

OF CLAIMANT OF RIGHT TO APPROPRIATE GROUND WATER

TO THE STATE ENGINEER OF OREGON:

I, William Shenker and Elizabeth Shenker, dba William Shenker Company

of 12005 N. Burgard Street, Portland County of Multnomah
(Mailing address)

State of Oregon, do hereby make application for a certificate of registration as evidence of a right to appropriate ground water.

1. Source from which water is withdrawn is # 1 WELL; PUMPED WELL.
(Flowing well, pump well, infiltration trench, or tunnel)

2. Location is: 1/4 MILE NORTH OF CITY OF PORTLAND LIMITS
(Approximate distance and direction from nearest city or town)

and is more particularly described as follows:

(a) 1060 FT. WEST; 1690 FT. NORTH OF S. E. COR. OF SEC. 35; 2N.; 1W.
(Give distance and bearing to corner of section or other legal subdivision)

being within N. E. 1/4 of SE 1/4 of Sec. 35, Twp. 2 NORTH, Rge. 1 WEST
(Smallest legal subdivision) (N. or S.) (E. or W.)

or (b) within limits of recorded platted property, town or city:

in Lot _____, Block _____ of _____
(Name of plat or addition)

(If within city or town, give name) County of _____

3. Construction Work was begun on EARLY SUMMER 1944 was completed on LATE FALL 1944
(Date) (Date)

and the ground water claimed was first used for the purposes set out below on FALL OF 1944
(Date)

since which time the water has been used CONTINUOUSLY
(Continuously or intermittently)

from 1944 to PRESENT.
(Date) (Date)

4. Quantity of water claimed and used is 800 gallons per minute; _____ acre feet per year.

5. Purpose or Purposes for which water is used DOMESTIC, MANUFACTURING, AND INDUSTRIAL
(Domestic, irrigation, municipal, manufacturing, industrial, etc.)

6. Description of Well: Depth 90 feet. Type DRILLED
(Dug or drilled)

diameter 12 inches. Elevation of ground at well site 30 feet, mean sea level.
(As near as known)

Depth to water table 30 feet.

7. Capacity of Well: 1000 g.p.m. with 10 feet drawdown.
_____ g.p.m. with _____ feet drawdown.

Date of test JUNE 12, 1958

If Flowing Well: Measured discharge _____ g.p.m. on _____
(Date)

Shut-in pressure at ground surface _____ lbs. per sq. in. on _____
(Date)

Water is controlled by _____
(Cap, valve, etc.)

8. Casing: (Give diameter, commercial specifications and depth below ground surface of each casing size.)

12 inch diameter from SURFACE to 80 feet
..... inch diameter from to feet
..... inch diameter from to feet
..... inch diameter from to feet

Describe and show depth of shoe, plug, adapter, liner or other details:

.....
.....

9. Perforated Casings or Screens:

..... from 70 FT to 80 FT
(Number per foot and size of perforations, or describe screen)
..... from to
..... from to
..... from to

10. Log of Well: (Describe each stratum or formation clearly, indicate if water bearing, and give thickness and depth as indicated.)

MATERIAL	Thickness (Feet)	Depth to Bottom (Feet)

If log of well is not available, give name and address of driller, JANNSEN DRILLING CO.

ROUTE 1, ALOHA, OREGON

11. Infiltration Trench: Covered or open

Dimensions: Length ft. Minimum depth ft. Maximum depth ft.

Bottom width ft. Discharge g.p.m. Date of test

12. Tunnel: Type of lining

Dimensions:
(Length, course, and cross sectional size)

Position of water bearing stratum with reference to portal of tunnel

Log of tunnel: (Preceding table for log of well may be used, if desired. Give footage from portal and character of materials, as pertinent.)

13. Pumping Equipment:

(a) Pump FAIRBANKS-MORSE, 8", DEEP WELL 70 FT. DEEP Capacity 1200 g.p.m.
(Make, type and size)


(b) Motor F-M, 30 H.P. ELECTRIC
(Type and horsepower)

14. Location of area irrigated or to be irrigated, or place of use if for purposes other than irrigation.

Township North or South	Range E. or W. of Willamette Meridian	Section	Forty-acre Tract	Number Acres To Be Irrigated	Date of Reclamation
<u>T2N</u>	<u>R1W</u>	<u>35</u>	<u>NE 1/4 of SE 1/4</u>	<u>Mfg & Ind.</u>	<u>1944</u>

15. If the ground water supply is supplemental to an existing water supply, identification of any application for a permit, permit, certificate or adjudicated right to appropriate water made or held by the registrant.

Township 2 N Range 1 W, W.M.
North

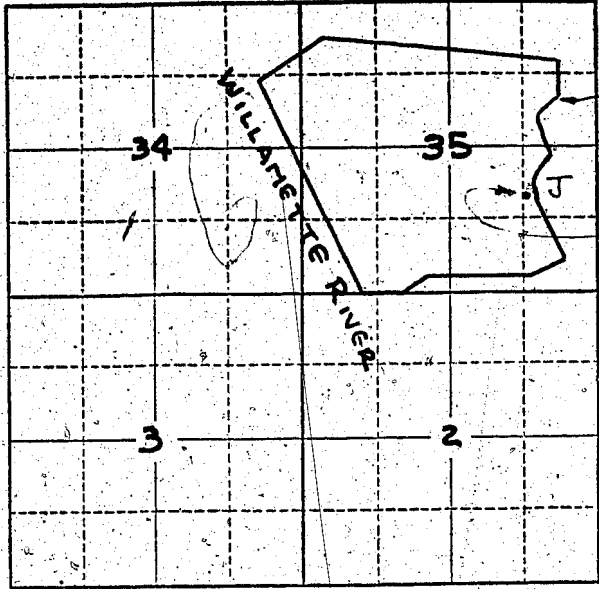

Locate well and acreage of irrigated land on plat.
Scale: 2" = 1 Mile

STATE OF OREGON }
County of Marion } ss.

I, William Sheehan, being first duly sworn, do hereby certify that I have read the foregoing Registration Statement and that all of the items therein contained are true to the best of my knowledge and belief.

William Sheehan
William Sheehan
(Signature of Registrant)

Subscribed and sworn to before me this 24 day of July, 1958

My commission expires 3/23/1960
William Sheehan
(Notary Public)

(SEAL)

CERTIFICATE OF REGISTRATION

STATE OF OREGON }
County of Marion } ss.

This is to certify that the foregoing Registration Statement was received in the office of the State Engineer on the 25th day of July, 1958, at 8:00 o'clock A. M. and has been duly recorded in said office in Book No. 11 of Registration Statements on page GR 2553

Witness my hand this 6th day of April, 1959

W. A. Stanley
(State Engineer)

22⁰⁰

By _____
(Deputy)