REGISTRATION NO. GR-270

CERTIFICATE NO. GR-248

# Registration Statement

## OF CLAIMANT OF RIGHT TO APPROPRIATE GROUND WATER

(Under Chapter 708, Oregon Laws 1955.)

**TO THE STATE ENGINEER OF OREGON:**

I, Loren E. Powell,

of Rt. 1 Box 723 Salem County of Polk.

State of Oregon, do hereby make application for a certificate of registration as evidence of a right to appropriate ground water.

1. **Source** from which water is withdrawn is pump well (Flowing well, pump well, infiltration trench, or tunnel)

2. **Location** is: 10 miles north + west of Salem (Approximate distance and direction from nearest city or town);

and is more particularly described as follows:

(a) 773 ft. South + 621 ft. East of N.W. corner of Section 20 (Give distance and bearing to corner of section or other legal subdivision)

being within Lot 22 + part of Lot 21 in N.W. 1/4 of N.W. 1/4 (Smallest legal subdivision) of Sec. 20, Twp. 6 S (N. or S.), Rge. 3 W (E. or W.)

or (b) within limits of recorded platted property, town or city:

in Lot ....., Block ..... of ..... (Name of plat or addition)

..... County of ..... (If within city or town, give name)

3. **Construction Work** was begun on about 1942 (Date); was completed on not known (Date)

and the ground water claimed was first used for the purposes set out below on May 3 1946 (Date),

since which time the water has been used continuously (Continuously or intermittently)

from May 3, 1946 (Date) to Sept 1956 (Date)

4. **Quantity** of water claimed and used is ~~[illegible]~~ 50 gallons per minute; ..... acre feet per year.

5. **Purpose or Purposes** for which water is used

Domestic and irrigation (Domestic, irrigation, municipal, manufacturing, industrial, etc.)

6. **Description of Well:** Depth 96 feet. Type drilled (Dug or drilled)

diameter 6 inches. Elevation of ground at well site ~~[illegible]~~ 160 (As near as known) feet, mean sea level.

Depth to water table 36 feet.

7. **Capacity of Well:** ..... g.p.m. with ..... feet drawdown.

..... g.p.m. with ..... feet drawdown.

Date of test not tested

**If Flowing Well:** Measured discharge ..... g.p.m. on ..... (Date)

Shut-in pressure at ground surface ..... lbs. per sq. in. on ..... (Date)

Water is controlled by ..... (Cap, valve, etc.)

8. **Casing:** (Give diameter, commercial specifications and depth below ground surface of each casing size.)

6 inch diameter ..... from ..... to ..... feet

..... inch diameter ..... from ..... to ..... feet

..... inch diameter not known from ..... to ..... feet

..... inch diameter ..... from ..... to ..... feet

Describe and show depth of shoe, plug, adapter, liner or other details: .....

9. **Perforated Casings or Screens:**

..... from ..... to .....
(Number per foot and size of perforations, or describe screen)

..... from ..... to .....

not known from ..... to .....

..... from ..... to .....

10. **Log of Well:** (Describe each stratum or formation clearly, indicate if water bearing, and give thickness and depth as indicated.)

| MATERIAL | Thickness (Feet) | Depth to Bottom (Feet) |
|---|---|---|
| no Log available | | |
| well was drilled before I owned the | | |
| farm and I have no idea who drilled the | | |
| well or when. | | |

GR-248 A

If log of well is not available, give name and address of driller. Not Known

11. **Infiltration Trench:** Covered or open .....

Dimensions: Length ..... ft. Minimum depth ..... ft. Maximum depth ..... ft.

Bottom width ..... ft. Discharge ..... g.p.m. Date of test .....

12. **Tunnel:** Type of lining .....

Dimensions: .....
(Length, course, and cross sectional size)

Position of water bearing stratum with reference to portal of tunnel .....

Log of tunnel: (Preceding table for log of well may be used, if desired. Give footage from portal and character of materials, as pertinent.)

13. **Pumping Equipment:**

(a) Pump Berkley Deep well jet 3 horsepower (Make, type and size) Capacity 50 g.p.m.

(b) Motor Westinghouse Single phase 60 cycle 3 horsepower (Type and horsepower)

14. Location of area irrigated or to be irrigated, or place of use if for purposes other than irrigation.

| Township North or South | Range E. or W. of Willamette Meridian | Section | Forty-acre Tract | Number Acres To Be Irrigated | Date of Reclamation |
|---|---|---|---|---|---|
| 6S | 3W | 20 | N.W. 1/4 of N.W. 1/4 | 10 acres | May 3 1956 |
| | | | | | |
| | | | | | |
15. If the ground water supply is supplemental to an existing water supply, identification of any application for a permit, permit, certificate or adjudicated right to appropriate water made or held by the registrant.

.....

.....

GR-248B

Township 6 S Range 3 W, W.M.

North

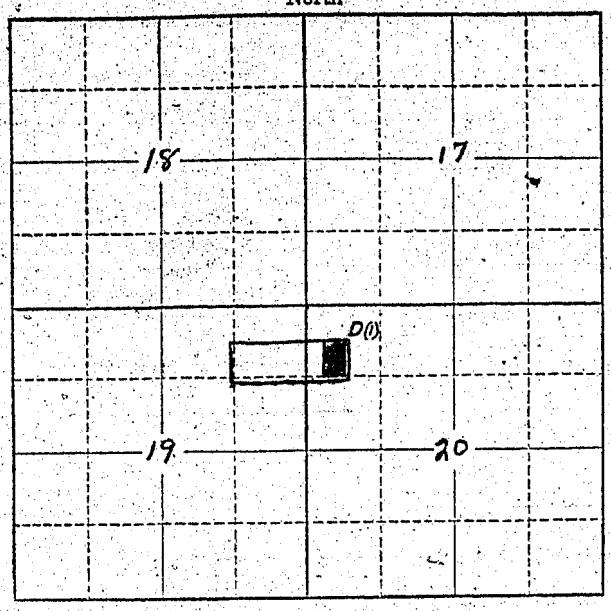


Dot shows Location of well + area in Red will be irrigated.

Locate well and acreage of irrigated land on plat.

Scale: 2" = 1 Mile

STATE OF OREGON
County of Marion } ss.

I, Loren E. Powell, being first duly sworn, do hereby certify that I have read the foregoing Registration Statement and that all of the items therein contained are true to the best of my knowledge and belief.

Loren E. Powell
(Signature of Registrant)

Subscribed and sworn to before me this 12th day of October, 1956.

My commission expires April 6, 1959

Wm Blinn
(Notary Public)

(SEAL)

## CERTIFICATE OF REGISTRATION

STATE OF OREGON
County of Marion } ss.

This is to certify that the foregoing Registration Statement was received in the office of the State Engineer on the 12th day of October, 19 56, at 10 o'clock A. M. and has been duly recorded in said office in Book No. 2 of Registration Statements on page GR-248-C

~~Construction shall be completed by X-X-X-X-X-X-X-X-X-X-X-X and the water put to beneficial use by X-X-X-X-X-X-X-X-X-X-X-X-X-X-~~

Witness my hand this 15th day of January, 1957.

Lewis A. Stanley
(State Engineer)

By
(Deputy)

GR-248C