

RECEIVED
DIVISION OF
STATE ENGINEER
SALE PERMITS

Registration No. GR - 2700

Certificate No. GR - 2558

Registration Statement

WELL NO. 3

OF CLAIMANT OF RIGHT TO APPROPRIATE GROUND WATER

TO THE STATE ENGINEER OF OREGON:

I, FRED G. KNOX

of Route #2, Box 282, Eugene County of Lane
(Mailing address)

State of Oregon, do hereby make application for a certificate of registration as evidence of a right to appropriate ground water.

1. Source from which water is withdrawn is #3 - 4" driven pump well
(Flowing well, pump well, infiltration trench, or tunnel)

2. Location is: 4 miles Northeast of Eugene
(Approximate distance and direction from nearest city or town)

and is more particularly described as follows:

(a) 30' North and 1860' East of Southwest corner Section 10, T17S, R3W
(Give distance and bearing to corner of section or other legal subdivision)

being within S.E. 1/4 of S.W. 1/4 of Sec. 10 Twp. 17 South Rge. 3 West
(Smallest legal subdivision) (N. or S.) (E. or W.)

or (b) within limits of recorded platted property, town or city:

in Lot _____, Block _____ of _____
(Name of plat or addition)

County of Lane
(If within city or town, give name)

3. Construction Work was begun on 1950; was completed on 1950
(Date) (Date)

and the ground water claimed was first used for the purposes set out below on 1950
(Date)

since which time the water has been used continuously
(Continuously or intermittently)

from 1950 to 1958
(Date) (Date)

4. Quantity of water claimed and used is 150 gallons per minute; 24 acre feet per year.

5. Purpose or Purposes for which water is used irrigation

(Domestic, irrigation, municipal, manufacturing, industrial, etc.)

6. Description of Well: Depth 20 feet. Type Driven
(Dug or drilled)

diameter 4 inches. Elevation of ground at well site 420 feet, mean sea level.
(As near as known)

Depth to water table 16 feet.

7. Capacity of Well: 250 g.p.m. with 3 feet drawdown.

 g.p.m. with feet drawdown.

Date of test estimated

If Flowing Well: Measured discharge g.p.m. on
(Date)

Shut-in pressure at ground surface lbs. per sq. in. on
(Date)

Water is controlled by
(Cap, valve, etc.)

8. Casing: (Give diameter, commercial specifications and depth below ground surface of each casing size.)

..... inch diameter from to feet
..... inch diameter from to feet
..... inch diameter from to feet
..... inch diameter from to feet

Describe and show depth of shoe, plug, adapter, liner or other details:

9. Perforated Casings or Screens:

..... **Drilled well point** from 16 to 20
(Number per foot and size of perforations, or describe screen)
..... from to
..... from to
..... from to

10. Log of Well: (Describe each stratum or formation clearly, indicate if water bearing, and give thickness and depth as indicated.)

MATERIAL	Thickness (Feet)	Depth to Bottom (Feet)
8' Soil and Loam	8	8
12' Sand and Gravel	8	20

If log of well is not available, give name and address of driller. _____

11. Infiltration Trench: Covered or open _____

Dimensions: Length _____ ft. Minimum depth _____ ft. Maximum depth _____ ft.

Bottom width _____ ft. Discharge _____ g.p.m. Date of test _____

12. Tunnel: Type of lining _____

Dimensions: _____
(Length, course, and cross sectional size)

Position of water bearing stratum with reference to portal of tunnel _____

Log of tunnel: (Preceding table for log of well may be used, if desired. Give footage from portal and character of materials, as pertinent.)

13. Pumping Equipment:

(a) Pump Fairbanks-Morse 3" Centrifugal Capacity 200 g.p.m.
(Make, type and size)


(b) Motor Electric Motor
(Type and horsepower)

14. Location of area irrigated or to be irrigated, or place of use if for purposes other than irrigation.

Township North or South	Range E. or W. of Willamette Meridian	Section	Forty-acre Tract	Number Acres To Be Irrigated	Date of Reclamation
17 South	3 West	10	S.E. 1/4, S.W. 1/4	10	1950
17 South	3 West	15	N.E. 1/4, N.W. 1/4	10	"
				<u>20</u>	

15. If the ground water supply is supplemental to an existing water supply, identification of any application for a permit, permit, certificate or adjudicated right to appropriate water made or held by the registrant.

Township 17S Range 3W W.M.
North

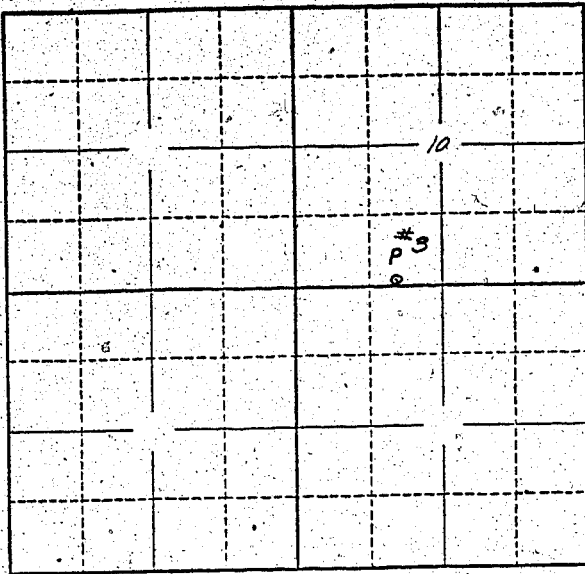

Locate well and acreage of irrigated land on plat.
Scale: 2" = 1 Mile

STATE OF OREGON

County of JANE

} ss.

I, Fred G. Knox, being first duly sworn, do hereby certify that I have read the foregoing Registration Statement and that all of the items therein contained are true to the best of my knowledge and belief.

Fred G. Knox
(Signature of Registrant)

Subscribed and sworn to before me this 24th day of July, 1958.

My commission expires May 30, 1961

Ollis R. Chamberlain
(Notary Public)

(SEAL)

CERTIFICATE OF REGISTRATION

STATE OF OREGON

County of Marion

} ss.

This is to certify that the foregoing Registration Statement was received in the office of the State Engineer on the 25th day of July, 1958, at 9³⁰ o'clock A. M. and has been duly recorded in said office in Book No. 11 of Registration Statements on page GR-2558

Witness my hand this 6th day of April, 1959.

Lewis A. Stanley
(State Engineer)

By

(Deputy)

#15.00

GR - 2558