

Registration Statement

OF CLAIMANT OF RIGHT TO APPROPRIATE GROUND WATER

TO THE STATE ENGINEER OF OREGON:

I, Gilbert E Haury
of Rt 2 Box 518 Salem Oregon County of Marion
(Mailing address)

State of _____, do hereby make application for a certificate of registration as evidence of a right to appropriate ground water.

- 1. Source from which water is withdrawn is Well (Flowing well, pump well, infiltration trench, or tunnel)
- 2. Location is: 2 Miles west of Central Hewell School (7 mi. W. of Salem) (Approximate distance and direction from nearest city or town)

and is more particularly described as follows:
1910 feet east & 850 feet North from SW corner Section 3.

(a) 215' East & 210' South of Property Corner - NE Corner (Give distance and bearing to corner of section or other legal subdivision)
being within SE 1/4 of SW 1/4 of Sec. 3, Twp. 7S, Rge. 2W (Smallest legal subdivision) (N. or S.) (E. or W.)

or (b) within limits of recorded platted property, town or city:
in Lot _____, Block _____ of _____ (Name of plat or addition)

County of Marion (If within city or town, give name)

3. Construction Work was begun on Sept. 1920; was completed on Oct. 1950 (Date) (Date)

and the ground water claimed was first used for the purposes set out below on 1951 (Date)

since which time the water has been used each summer (Continuously or intermittently)

from 1951 to Present (Date) (Date)

4. Quantity of water claimed and used is 30 gallons per minute; 1/2-1 acre feet per year.

5. Purpose or Purposes for which water is used Irrigate Berries - Orchard (Domestic, irrigation, municipal, manufacturing, industrial, etc.)

6. Description of Well: Depth 100 feet. Type Drilled (Dug or drilled)

diameter 6 inches. Elevation of ground at well site 210 feet, mean sea level. (As near as known)

Depth to water table 45' feet.

7. Capacity of Well: 40 g.p.m. with 25 feet drawdown.
_____ g.p.m. with _____ feet drawdown.

Date of test Sept - 1950

If Flowing Well: Measured discharge _____ g.p.m. on _____ (Date)

Shut-in pressure at ground surface _____ lbs. per sq. in. on _____ (Date)

Water is controlled by _____ (Cap, valve, etc.)

8. Casing: (Give diameter, commercial specifications and depth below ground surface of each casing size.)

6 inch diameter steel casing from 0 to 100' feet
 inch diameter from to feet
 inch diameter from to feet
 inch diameter from to feet

Describe and show depth of shoe, plug, adapter, liner or other details: _____

9. Perforated Casings or Screens:

No- from to
 (Number per foot and size of perforations, or describe screen)
 from to
 from to
 from to

10. Log of Well: (Describe each stratum or formation clearly, indicate if water bearing, and give thickness and depth as indicated.)

MATERIAL	Thickness (Feet)	Depth to Bottom (Feet)
<u>Not Available</u>		

If log of well is not available, give name and address of driller. Stadley & Son

Silverton

11. Infiltration Trench: Covered or open _____

Dimensions: Length _____ ft. Minimum depth _____ ft. Maximum depth _____ ft.

Bottom width _____ ft. Discharge _____ g.p.m. Date of test _____

12. Tunnel: Type of lining _____

Dimensions: _____
(Length, course, and cross sectional size)

Position of water bearing stratum with reference to portal of tunnel _____

Log of tunnel: (Preceding table for log of well may be used, if desired. Give footage from portal and character of materials, as pertinent.)

13. Pumping Equipment:

(a) Pump Jet. 3 H.P. Berkley Capacity 3.5 g.p.m.
(Make, type and size)


(b) Motor 3 H.P.
(Type and horsepower)

14. Location of area irrigated or to be irrigated, or place of use if for purposes other than irrigation.

Township North or South	Range E. or W. of Williamsite Meridian	Section	Forty-acre Tract	Number Acres To Be Irrigated	Date of Reclamation
7.5	2.4	10	NE 1/4 of NW 1/4	15 15	1958
7.5	2.4	3	SE 1/4 of SW 1/4	8.0 8.0	1951
				<u>9.5</u>	

15. If the ground water supply is supplemental to an existing water supply, identification of any application for a permit, permit, certificate or adjudicated right to appropriate water made or held by the registrant.

Township 7S Range 2W W.M.
North

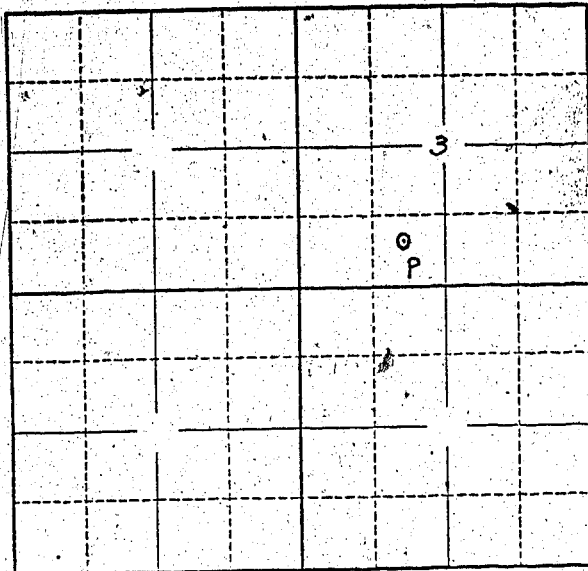

Locate well and acreage of irrigated land on plat.
Scale: 2" = 1 Mile

STATE OF OREGON

County of Marion } ss.

I, GILBERT E. HAURY being first duly sworn, do hereby certify that I have read the foregoing Registration Statement and that all of the items therein contained are true to the best of my knowledge and belief.

Gilbert E. Haury
(Signature of Registrant)

Subscribed and sworn to before me this 25th day of July, 1958

My commission expires April 3, 1961

A. M. Pettit
(Notary Public for Oregon)

(SEAL)

CERTIFICATE OF REGISTRATION

STATE OF OREGON } ss.
County of Marion

This is to certify that the foregoing Registration Statement was received in the office of the State Engineer on the 25th day of July, 1958, at 11:00 o'clock A. M. and has been duly recorded in said office in Book No. 11 of Registration Statements on page GR 2559

Witness my hand this 6th day of April, 1959

#15.00

Lewis H. Stanley
(State Engineer)

By _____ (Deputy)

GR - 2559