

RECEIVED
JUL 24 1953
STATE ENGINEER
SALES OFFICE

Registration No. GR-2704

Certificate No. GR-3883

Registration Statement

OF CLAIMANT OF RIGHT TO APPROPRIATE GROUND WATER

TO THE STATE ENGINEER OF OREGON:

I, JOE GROSJACQUES

of 5720 NE 138th AVE PORTLAND County of MULTNOMAH
(Mailing address)

State of ORE., do hereby make application for a certificate of registration as evidence of a right to appropriate ground water.

1. Source from which water is withdrawn is PUMP WELL #21
(Flowing well, pump well, infiltration trench, or tunnel)

2. Location is: 2 MILES EAST OF PARK ROSE ORE.
(Approximate distance and direction from nearest city or town)

and is more particularly described as follows: 200 feet west and 560 feet south from NE Corner S4 23
FROM SE CORNER OF LOT 86 REYNOLDS MOUNTAIN VIEW

(a) PLAT 1 S52° SOUTH AND THEN 750' E TO WELL
(Give distance and bearing to corner of section or other legal subdivision)

being within TRACT OF LAND ADJOINING REYNOLDS MOUNTAIN VIEW of Sec. 133, Twp. 1 North, Rge. 2 EAST
(Smallest legal subdivision) (N. 133) (E. 2)

or (b) within limits of recorded platted property, town or city:

in Lot _____, Block _____ of _____
(Name of plat or addition)

County of MULTNOMAH
(If within city or town, give name)

3. Construction Work was begun on APRIL 1950; was completed on APRIL 1950
(Date) (Date)

and the ground water claimed was first used for the purposes set out below on 1950
(Date)

since which time the water has been used CONTINUOUSLY
(Continuously or intermittently)

from 1950 to PRESENT
(Date) (Date)

4. Quantity of water claimed and used is 300 gallons per minute; _____ acre feet per year.

5. Purpose or Purposes for which water is used IRRIGATION

(Domestic, irrigation, municipal, manufacturing, industrial, etc.)

6. Description of Well: Depth 53 feet. Type DRIELED
(Dug or drilled)

diameter 12 inches. Elevation of ground at well site 50 feet, mean sea level.
(As near as known)

Depth to water table 12' feet.

7. Capacity of Well: 370 g.p.m. with 10 feet drawdown.

_____ g.p.m. with _____ feet drawdown.

Date of test 1950

If Flowing Well: Measured discharge _____ g.p.m. on _____
(Date)

Shut-in pressure at ground surface _____ lbs. per sq. in. on _____
(Date)

Water is controlled by _____
(Cap, valve, etc.)

8. Casing: (Give diameter, commercial specifications and depth below ground surface of each casing size.)

12 inch diameter from 0 to 55 feet
 inch diameter from to feet
 inch diameter from to feet
 inch diameter from to feet

Describe and show depth of shoe, plug, adapter, liner or other details:

9. Perforated Casings or Screens:

none from to
 (Number per foot and size of perforations, or describe screen)
 from to
 from to
 from to

10. Log of Well: (Describe each stratum or formation clearly, indicate if water bearing, and give thickness and depth as indicated.)

MATERIAL	Thickness (Feet)	Depth to Bottom (Feet)
SOIL + SILT	0	32
BOULDER SILT	32	36
SANDY	36	39
GRAVEL + SOME SAND	39	47
SAND ALONE	47	49
SAND + GRAVEL	49	53

If log of well is not available, give name and address of driller.

11. Infiltration Trench: Covered or open

Dimensions: Length ft. Minimum depth ft. Maximum depth ft.
 Bottom width ft. Discharge g.p.m. Date of test

12. Tunnel: Type of lining

Dimensions: (Length, course, and cross sectional size)
 Position of water bearing stratum with reference to portal of tunnel

Log of tunnel: (Preceding table for log of well may be used, if desired. Give footage from portal and character of materials, as pertinent.)

13. Pumping Equipment:


(a) Pump JUCO 321 - CENTRIFUGAL 3" OUTLET Capacity 3.00 g.p.m.
(Make, type and size)
 (b) Motor ELECTRIC - 10 H.P.
(Type and horsepower)

14. Location of area irrigated or to be irrigated, or place of use if for purposes other than irrigation.

Township North or South	Range E. or W. of Willamette Meridian	Section	Forty-acre Tract	Number Acres To Be Irrigated	Date of Reclamation
T1N	R2E	13	SW $\frac{1}{4}$ of SW $\frac{1}{4}$	2.0	1950
"	"	14	SE $\frac{1}{4}$ of SE $\frac{1}{4}$	0.5	"
"	"	24	NW $\frac{1}{4}$ of NW $\frac{1}{4}$	1.68	"
"	"	23	NE $\frac{1}{4}$ of NE $\frac{1}{4}$	13.2 17.18	"

15. If the ground water supply is supplemental to an existing water supply, identification of any application for a permit, permit, certificate or adjudicated right to appropriate water made or held by the registrant.

Township 1N Range 2E, W.M.
North

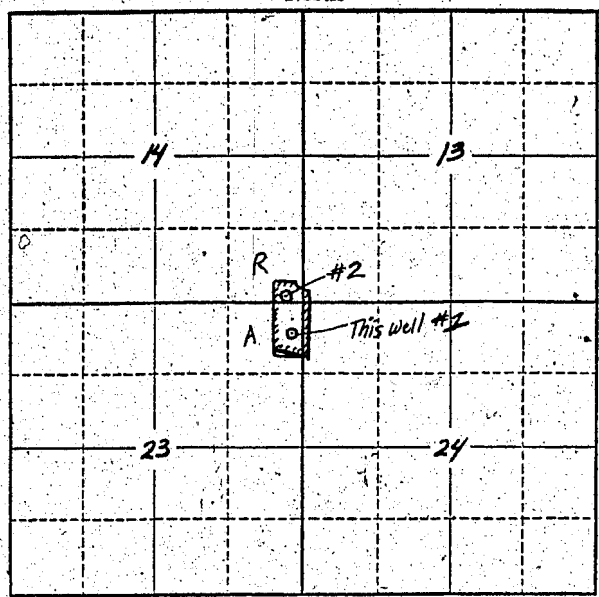

Locate well and acreage of irrigated land on plat.
Scale: 2" = 1 Mile

STATE OF OREGON }
County of _____ } ss.

I, _____, being first duly sworn, do hereby certify that I have read the foregoing Registration Statement and that all of the items therein contained are true to the best of my knowledge and belief.

[Handwritten Signature]
(Signature of Registrant)

Subscribed and sworn to before me this 24th day of July, 1958

My commission expires March 30, 1962 *[Handwritten Signature]*
(Notary Public)

(SEAL)

CERTIFICATE OF REGISTRATION

STATE OF OREGON }
County of Marion } ss.

This is to certify that the foregoing Registration Statement was received in the office of the State Engineer on the 25 day of July, 1958, at 10⁰⁰ o'clock A.M. and has been duly recorded in said office in Book No. 16 of Registration Statements on page GR-3883

Witness my hand this 15th day of February, 1960

[Handwritten Signature]
(State Engineer)

By _____ (Deputy)

\$15.00

GR 3883