

Registration Statement

OF CLAIMANT OF RIGHT TO APPROPRIATE GROUND WATER

TO THE STATE ENGINEER OF OREGON:

I, E. L. FRANKLIN
of Rt. Box 110 Silverton County of Wagon
(Mailing address)

State of Oreg, do hereby make application for a certificate of registration as evidence of a right to appropriate ground water.

1. Source from which water is withdrawn is Well
(Flowing well, pump well, infiltration trench, or tunnel)

2. Location is: 4 miles north east of Silverton
(Approximate distance and direction from nearest city or town)

and is more particularly described as follows:

(a) 1600 north 120° east from south west corner
(Give distance and bearing to corner of section or other legal subdivision)

being within North 2 1/2 of S.W. 4 of Sec. 7, Twp. 6 S, Rge. 1 East
(Smallest legal subdivision) (N. or S.) (E. or W.)

or (b) within limits of recorded platted property, town or city: ?

in Lot _____, Block _____ of _____
(Name of plat or addition)

County of _____
(If within city or town, give name)

3. Construction Work was begun on Dec. 27-44, was completed on Jan. 10-45
(Date) (Date)

and the ground water claimed was first used for the purposes set out below on 1945
(Date)

since which time the water has been used Continuously
(Continuously or Intermittently)

from 1945 to 1958
(Date) (Date)

4. Quantity of water claimed and used is 30 gallons per minute; 15 acre feet per year.

5. Purpose or Purposes for which water is used Irrigation & Farm use
(Domestic, irrigation, municipal, manufacturing, industrial, etc.)

6. Description of Well: Depth 82 feet. Type Drilled
(Dug or drilled)

diameter 6 inches. Elevation of ground at well site 110 feet, mean sea level.
(As near as known)

Depth to water table 40 feet.

7. Capacity of Well: 20 g.p.m. with 25 feet drawdown.

_____ g.p.m. with _____ feet drawdown.


Date of test July 3-57

If Flowing Well: Measured discharge _____ g.p.m. on _____
(Date)

Shut-in pressure at ground surface _____ lbs. per sq. in. on _____
(Date)

Water is controlled by _____
(Cap, valve, etc.)

Township 65 Range 10 W.M.
North.

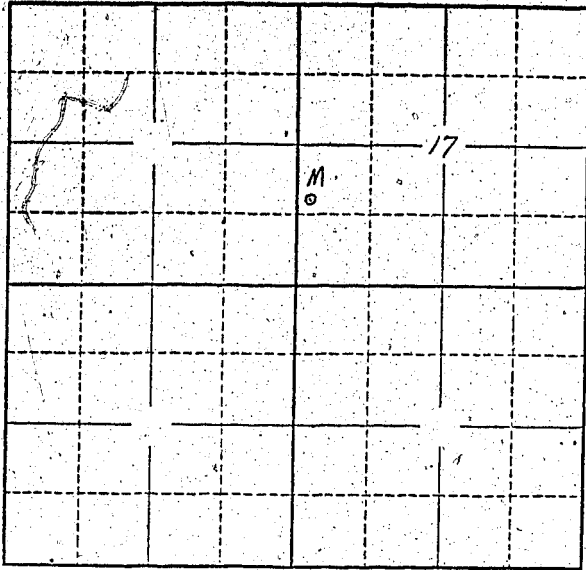

Locate well and acreage of irrigated land on plat.
Scale: 2" = 1 Mile

STATE OF OREGON

County of Marion } ss.

I, E. S. Ferrimore, being first duly sworn, do hereby certify that I have read the foregoing Registration Statement and that all of the items therein contained are true to the best of my knowledge and belief.

E. S. Ferrimore
(Signature of Registrant)

Subscribed and sworn to before me this 25th day of July, 1958

My commission expires 12th June 1961 Wm. S. Bartholomew
(Notary Public)

(SEAL)

CERTIFICATE OF REGISTRATION

STATE OF OREGON } ss.
County of Marion

This is to certify that the foregoing Registration Statement was received in the office of the State Engineer on the 25th day of July, 1958, at 10⁰⁰ o'clock A. M. and has been duly recorded in said office in Book No. 11 of Registration Statements on page GR-2562

Witness my hand this 6th day of April, 1959

Lewis A. Stanley
(State Engineer)

By _____
(Deputy)

GR 2562

\$15.00