

# Registration Statement

## OF CLAIMANT OF RIGHT TO APPROPRIATE GROUND WATER

TO THE STATE ENGINEER OF OREGON:

I, HELEN BELL LARSON

of 555 Buena Vista Ave. W., San Francisco 17, Calif. County of Lane  
(Mailing address)

State of Oregon, do hereby make application for a certificate of registration as evidence of a right to appropriate ground water.

1. Source from which water is withdrawn is Pump Well #2  
(Flowing well, pump well, infiltration trench, or tunnel)

2. Location is: 1110 River Road, Eugene, Oregon  
(Approximate distance and direction from nearest city or town)

and is more particularly described as follows:

(a) 2050 ft. East & 360 ft. North of corner of James Watson D1C 17  
(Give distance and bearing to corner of section or other legal subdivision)

being within NW 1/4 of Sec. 2, Twp. 17 S, Rge. 5 W  
(Smallest legal subdivision) (N. or S.) (E. or W.)

or (b) within limits of recorded platted property, town or city:

in Lot \_\_\_\_\_, Block \_\_\_\_\_ of \_\_\_\_\_  
(Name of plat or addition)

\_\_\_\_\_ County of \_\_\_\_\_  
(If within city or town, give name)

3. Construction Work was begun on 1916; was completed on 1916  
(Date) (Date)

and the ground water claimed was first used for the purposes set out below on 1916  
(Date)

since which time the water has been used Continuously  
(Continuously or Intermittently)

from April 1916 to Oct. of each year to the present, Oct 1919  
(Date) (Date)

4. Quantity of water claimed and used is 210 gallons per minute; 1/3 acre feet per year.

5. Purpose or Purposes for which water is used Irrigation

(Domestic, irrigation, municipal, manufacturing, industrial, etc.)

6. Description of Well: Depth 20 feet. Type Driven  
(Dug or drilled)

diameter \_\_\_\_\_ inches. Elevation of ground at well site \_\_\_\_\_ feet, mean sea level.  
(As near as known)

Depth to water table 15 feet.

7. Capacity of Well: 310 g.p.m. with 20 feet drawdown.

\_\_\_\_\_ g.p.m. with \_\_\_\_\_ feet drawdown.

Date of test \_\_\_\_\_

If Flowing Well: Measured discharge \_\_\_\_\_ g.p.m. on \_\_\_\_\_  
(Date)


Shut-in pressure at ground surface \_\_\_\_\_ lbs. per sq. in. on \_\_\_\_\_  
(Date)

Water is controlled by \_\_\_\_\_  
(Cap. Valve, etc.)





Attached Map shows location of 3 wells  
Township 17S Range 40W, W.M.  
North

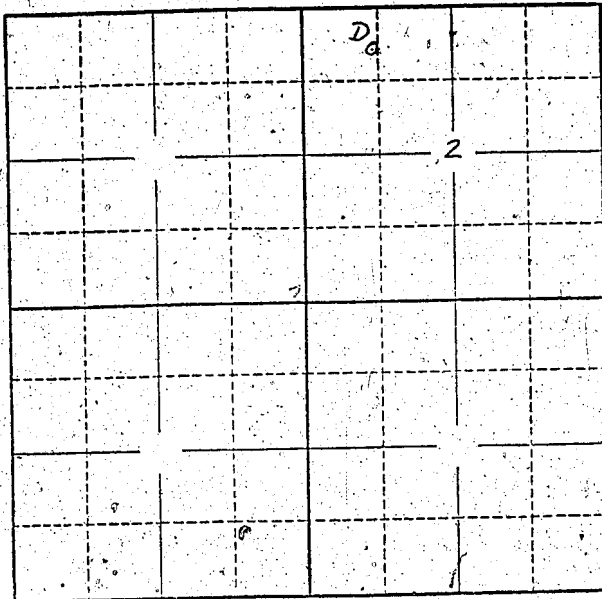

Locate well and acreage of irrigated land on plat.  
Scale: 2" = 1 Mile

STATE OF OREGON

County of \_\_\_\_\_ } ss.

I, \_\_\_\_\_ being first duly sworn, do hereby certify that I have read the foregoing Registration Statement and that all of the items therein contained are true to the best of my knowledge and belief.

\_\_\_\_\_  
(Signature of Registrant)

Subscribed and sworn to before me this 4 day of May, 1959

My Commission Expires June 30, 1961

My commission expires \_\_\_\_\_

\_\_\_\_\_  
(Notary Public)

(SEAL)

### CERTIFICATE OF REGISTRATION

STATE OF OREGON

County of Marion } ss.

This is to certify that the foregoing Registration Statement was received in the office of the State Engineer on the 25<sup>th</sup> day of July, 1958, at 1:00 o'clock P.M. and has been duly recorded in said office in Book No. 12 of Registration Statements on page GR-2857

Witness my hand this 25<sup>th</sup> day of May, 1959

\_\_\_\_\_  
(State Engineer)

By \_\_\_\_\_  
(Deputy)

~~\$15.50~~  
\$15.00

GR -2857