

# Registration Statement

## OF CLAIMANT OF RIGHT TO APPROPRIATE GROUND WATER

TO THE STATE ENGINEER OF OREGON:

I, Silas V Brewster  
of P.O. Box 207A, Jurner County of Marion  
State of Oregon, do hereby make application for a certificate of registration as evidence of a right to appropriate ground water.

1. Source from which water is withdrawn is Hall Pump - Sump (Flowing well, pump well, infiltration trench, or tunnel)

2. Location is: 1/2 mile north of north Santiam State (Approximate distance and direction from nearest city or town)

and is more particularly described as follows:  
73.58 Chains South + 23.06 Chains East of N.W. Corner of Henry Teeter D.L.C.

(a) S.L. 50 (Give distance and bearing to corner of section or other legal subdivision)

being within NE 1/4, SE 1/4 of Sec. 23, Twp. 9 S, Rge. 2 W (Smallest legal subdivision) (N. or S.) (E. or W.)

or (b) within limits of recorded platted property, town or city: North Santiam

in Lot \_\_\_\_\_, Block \_\_\_\_\_ of \_\_\_\_\_ (Name of plat or addition)

County of Marion (If within city or town, give name)

3. Construction Work was begun on May 18 1954; was completed on 25 May (Date) (Date)

and the ground water claimed was first used for the purposes set out below on May 28 1954 (Date)

since which time the water has been used \_\_\_\_\_ (Continuously or intermittently)

from May 1954 to July 1958 (Date) (Date)

4. Quantity of water claimed and used is 500 gallons per minute; \_\_\_\_\_ acre feet per year.

5. Purpose or Purposes for which water is used Irrigation

Irrigation (Domestic, irrigation, municipal, manufacturing, industrial, etc.)

6. Description of Well: Depth 17 feet. Type Hall Dug (Dug or drilled)

diameter 16 ft inches. Elevation of ground at well site \_\_\_\_\_ feet, mean sea level, (As near as known)

Depth to water table 9 ft feet.

7. Capacity of Well: 500 g.p.m. with 4 feet drawdown.

\_\_\_\_\_ g.p.m. with \_\_\_\_\_ feet drawdown.

Date of test May 26 1954

If Flowing Well: Measured discharge \_\_\_\_\_ g.p.m. on \_\_\_\_\_ (Date)


Shut-in pressure at ground surface \_\_\_\_\_ lbs. per sq. in. on \_\_\_\_\_ (Date)

Water is controlled by \_\_\_\_\_ (Cap, valve, etc.)





Township 9S Range 2W, W.M.  
North

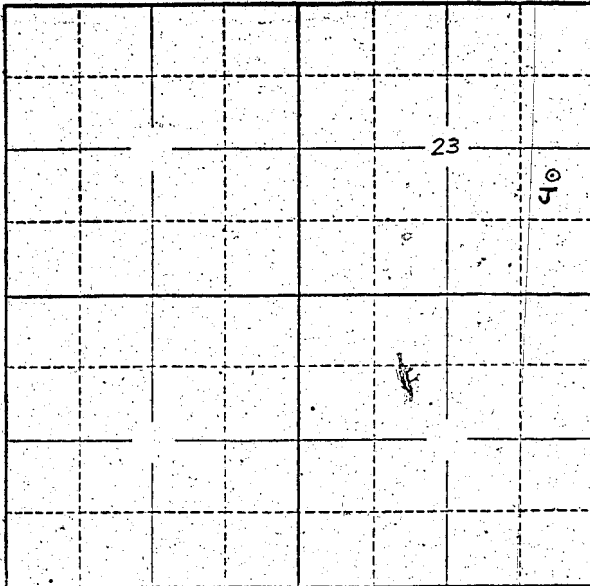

Locate well and acreage of irrigated land on plat.  
Scale: 2" = 1 Mile

STATE OF OREGON

County of Marion } ss.

I, Silas V Brewster, being first duly sworn, do hereby certify that I have read the foregoing Registration Statement and that all of the items therein contained are true to the best of my knowledge and belief.

Silas V Brewster  
(Signature of Registrant)

Subscribed and sworn to before me this 25th day of July, 1958

My commission expires 12th June 1961 Wm. B. Bartholmes  
(Notary Public)

(SEAL)

**CERTIFICATE OF REGISTRATION**

STATE OF OREGON

County of Marion } ss.

This is to certify that the foregoing Registration Statement was received in the office of the State Engineer on the 25th day of July, 1958, at 2:30 o'clock P. M. and has been duly recorded in said office in Book No. 11 of Registration Statements on page GR-2574

Witness my hand this 6th day of April, 1959

Wm. A. Stanley  
(State Engineer)

By \_\_\_\_\_  
(Deputy)

#1522

GR - 2574