

Registration Statement

OF CLAIMANT OF RIGHT TO APPROPRIATE GROUND WATER

TO THE STATE ENGINEER OF OREGON:

I, Ruby W. Dann

of 4246 River road Junction City County of Lane

State of Oregon, do hereby make application for a certificate of registration as evidence of a right to appropriate ground water.

1. Source from which water is withdrawn is Dump well #2
(Flowing well, pump well, infiltration trench, or tunnel)

2. Location is: 4 miles S Junction City
(Approximate distance and direction from nearest city or town)

and is more particularly described as follows:

(a) 50' S & 850' E of N.W. Cor. Sec. 22
(Give distance and bearing to corner of section or other legal subdivision)

being within N.W. 1/4 of N.W. 1/4 of Sec. 22, Twp. 16-S, Rge. 4-W
(Smallest legal subdivision) (N. or S.) (E. or W.)

or (b) within limits of recorded platted property, town or city:

in Lot _____, Block _____ of _____
(Name of plat or addition)

County of Lane

(If within city or town, give name)

3. Construction Work was begun on 1952; was completed on 1952
(Date) (Date)

and the ground water claimed was first used for the purposes set out below on 1952
(Date)

since which time the water has been used Intermittently
(Continuously or intermittently)

from May to Sept. each Summer
(Date) (Date)

4. Quantity of water claimed and used is 250 gallons per minute; 250 acre feet per year.

5. Purpose or Purposes for which water is used Irrigation

(Domestic, irrigation, municipal, manufacturing, industrial, etc.)

6. Description of Well: Depth 21 feet. Type Driven

diameter 4 inches. Elevation of ground at well site 330 feet, mean sea level.
(As near as known)

Depth to water table 12 feet.

7. Capacity of Well: 300 g.p.m. with 3 feet drawdown.

_____ g.p.m. with _____ feet drawdown.


Date of test _____

If Flowing Well: Measured discharge _____ g.p.m. on _____
(Date)

Shut-in pressure at ground surface _____ lbs. per sq. in. on _____
(Date)

Water is controlled by _____
(Cap, valve, etc.)

Township 16S Range 4W, W.M.
North

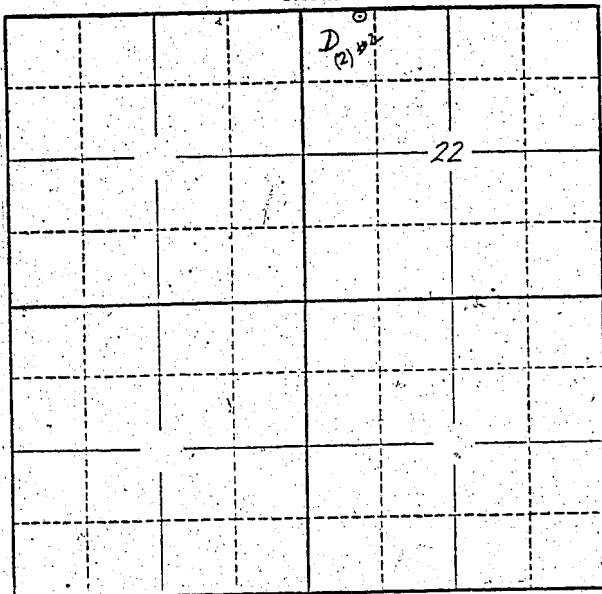

Locate well and acreage of irrigated land on plat.
Scale: 2" = 1 Mile

STATE OF OREGON

County of Linn } ss.

I, Ruby W. Danner, being first duly sworn, do hereby certify that I have read the foregoing Registration Statement and that all of the items therein contained are true to the best of my knowledge and belief.

Ruby W. Danner
(Signature of Registrant)

Subscribed and sworn to before me this 25th day of July, 1958

My commission expires April 11, 1960 John L. [Signature]
(Notary Public)

(SEAL)

CERTIFICATE OF REGISTRATION

STATE OF OREGON } ss.
County of Marion

This is to certify that the foregoing Registration Statement was received in the office of the State Engineer on the 25th day of July, 1958, at 10:30 o'clock A.M. and has been duly recorded in said office in Book No. 11 of Registration Statements on page GR-2578

Witness my hand this 6th day of April, 1959
[Signature]
(State Engineer)

#2565

By _____ (Deputy)