

# Registration Statement

## OF CLAIMANT OF RIGHT TO APPROPRIATE GROUND WATER

TO THE STATE ENGINEER OF OREGON:

I, Julius E. & Phyllis C. Purvine

of Route 4, Corvallis

(Mailing address)

County of Benton

State of Oregon

do hereby make application for a certificate of registration as evidence of a right to appropriate ground water.

1. Source from which water is withdrawn is

pump well #3

(Flowing well, pump well, infiltration trench, or tunnel)

2. Location is: 1 1/2 miles SE of Corvallis

(Approximate distance and direction from nearest city or town)

and is more particularly described as follows:

(a) 1010.5' S 28° 26' W to the SW corner

(Give distance and bearing to corner of section or other legal subdivision)

being within

SW 1/4 of SE 1

(Smallest legal subdivision)

of Sec. 12

Twp. 12S

Rge. 5W, W.M.

(E. or W.)

or (b) within limits of recorded platted property, town or city:

in Lot \_\_\_\_\_, Block \_\_\_\_\_ of \_\_\_\_\_

(Name of plat or addition)

County of \_\_\_\_\_

(If within city or town, give name)

3. Construction Work was begun on 1947

(Date)

; was completed on 1947

(Date)

and the ground water claimed was first used for the purposes set out below on 1947

(Date)

since which time the water has been used

Continuously

(Continuously or intermittently)

from 1947

(Date)

to 1957

(Date)

4. Quantity of water claimed and used is 800 when pumping gallons per minute; 223 acre feet per year.

5. Purpose or Purposes for which water is used

irrigation

(Domestic, irrigation, municipal, manufacturing, industrial, etc.)

6. Description of Well: Depth 29 feet. Type

drilled

(Dug or drilled)

diameter 10 inches. Elevation of ground at well site

220

feet, mean sea level.

(As near as known)

Depth to water table 12 feet.

7. Capacity of Well: 800 g.p.m. with 1 feet drawdown.

\_\_\_\_\_ g.p.m. with \_\_\_\_\_ feet drawdown.

Date of test 1947

If Flowing Well: Measured discharge \_\_\_\_\_ g.p.m. on \_\_\_\_\_

(Date)

Shut-in pressure at ground surface \_\_\_\_\_ lbs. per sq. in. on \_\_\_\_\_

(Date)

Water is controlled by \_\_\_\_\_

(Cap, valve, etc.)

8. Casing: (Give diameter, commercial specifications and depth below ground surface of each casing size.)

10 inch diameter steel from surface to 29 feet  
 inch diameter from to feet  
 inch diameter from to feet  
 inch diameter from to feet

Describe and show depth of shoe, plug, adapter, liner or other details:

9. Perforated Casings or Screens:

perforated, size and number unknown from 19' to 29'  
(Number per foot and size of perforations, or describe screen)  
 from to  
 from to  
 from to

10. Log of Well: (Describe each stratum or formation clearly, indicate if water bearing, and give thickness and depth as indicated.)

MATERIAL	Thickness (Feet)	Depth to Bottom (Feet)
unknown		

If log of well is not available, give name and address of driller. Bill Hamilton, Albany

11. Infiltration Trench: Covered or open .....

Dimensions: Length ..... ft. Minimum depth ..... ft. Maximum depth ..... ft.

Bottom-width ..... ft. Discharge ..... g.p.m. Date of test .....

12. Tunnel: Type of lining .....

Dimensions: .....  
(Length, course, and cross sectional size)

Position of water bearing stratum with reference to portal of tunnel .....

Log of tunnel: (Preceding table for log of well may be used, if desired. Give footage from portal and character of materials, as pertinent.)

13. Pumping Equipment:

(a) Pump 6 x 5 centrifugal ..... Capacity 800 ..... g.p.m.  
(Make, type and size)

(b) Motor 50 hp 3 phase electric .....  
(Type and horsepower)


14. Location of area irrigated or to be irrigated, or place of use if for purposes other than irrigation.

Township North or South	Range E. or W. of Willamette Meridian	Section	Forty-acre Tract	Number Acres To Be Irrigated	Date of Reclamation
12S	5W	12	SE <sub>1</sub> <sup>4</sup> SE <sub>2</sub> <sup>4</sup>	4	1947
12S	5W	12	SW <sub>1</sub> <sup>4</sup> SE <sub>2</sub> <sup>4</sup>	10	1947
12S	5W	12	NE <sub>1</sub> <sup>4</sup> SE <sub>2</sub> <sup>4</sup>	2	1947
12S	5W	12	NW <sub>1</sub> <sup>4</sup> SE <sub>2</sub> <sup>4</sup>	21	1947
12S	5W	12	SE <sub>1</sub> <sup>4</sup> SW <sub>2</sub> <sup>4</sup>	20	1947
12S	5W	12	NE <sub>1</sub> <sup>4</sup> SE <sub>2</sub> <sup>4</sup> <i>scully</i>	6	1947
12S	5W	13	NW <sub>1</sub> <sup>4</sup> NE <sub>2</sub> <sup>4</sup>	2	1947
			<i>scully</i>	<i>Ac</i>	

15. If the ground water supply is supplemental to an existing water supply, identification of any application for a permit, permit, certificate or adjudicated right to appropriate water made or held by the registrant.

Township 125 Range 5W, W.M.

North

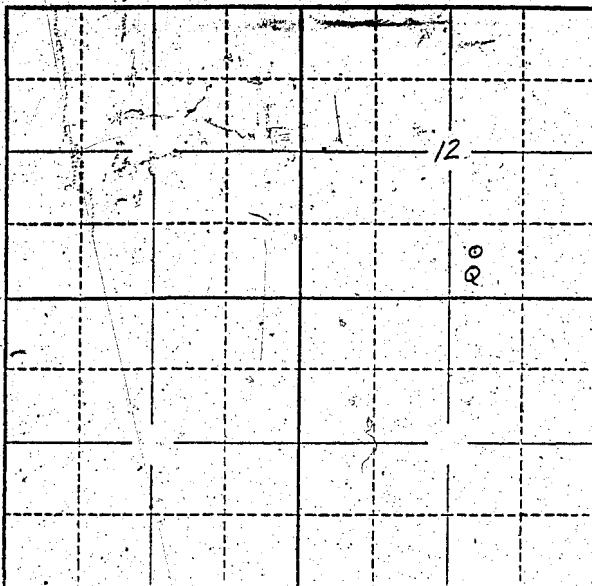

Locate well and acreage of irrigated land on plat.

Scale: 2" = 1 Mile

STATE OF OREGON

County of Benton

} ss.

I, Julius E. & Phyllis C. Purvine, being first duly sworn, do hereby certify that I have read the foregoing Registration Statement and that all of the items therein contained are true to the best of my knowledge and belief.

Julius E. Purvine  
Phyllis C. Purvine  
.....  
(Signature of Registrant)

Subscribed and sworn to before me this 21<sup>st</sup> day of July, 1958

My commission expires July 17, 1960

John J. Smith  
.....  
(Notary Public)

(SEAL)

**CERTIFICATE OF REGISTRATION**

STATE OF OREGON

County of Marion

} ss.

This is to certify that the foregoing Registration Statement was received in the office of the State Engineer on the 25 day of July, 1958, at 8:00 o'clock A.M. and has been duly recorded in said office in Book No. 11 of Registration Statements on page GR 2580

Witness my hand this 6<sup>th</sup> day of April, 1959

Edward W. Stanley  
.....  
(State Engineer)

By

.....  
(Deputy)

\$ 24.25

GR 2580