

# Registration Statement

## OF CLAIMANT OF RIGHT TO APPROPRIATE GROUND WATER

(Under Chapter 708, Oregon Laws 1955.)

TO THE STATE ENGINEER OF OREGON:

Julius E. & Phyllis C. Purvine

of Route 4, Corvallis County of Benton

State of Oregon do hereby make application for a certificate of registration as evidence of a right to appropriate ground water.

1. Source from which water is withdrawn is pump well  
(Flowing well, pump well, infiltration trench, or tunnel)

2. Location is: 1 1/2 miles south of Corvallis  
(Approximate distance and direction from nearest city or town)

and is more particularly described as follows:

(a) N 58° 30' W 975' to NW corner Sec 2, T 11S, R 5W, W.M. well being within  
(Give distance and bearing to corner of section or other legal subdivision)

being within N 1/4 N 1/4 of Sec. 2 Twp. 11S Rge. 5W  
(Smallest legal subdivision) (N. or S.) (E. or W.)

or (b) within limits of recorded platted property, town or city:

in Lot \_\_\_\_\_, Block \_\_\_\_\_ of \_\_\_\_\_  
(Name of plat or addition)

County of \_\_\_\_\_  
(If within city or town, give name)

3. Construction Work was begun on 1949; was completed on 1949  
(Date) (Date)

and the ground water claimed was first used for the purposes set out below on 1949  
(Date)

since which time the water has been used intermittently  
(Continuously or intermittently)

from 1949 to 1958  
(Date) (Date)

4. Quantity of water claimed and used is 700 when pumping gallons per minute; 130 acre feet per year.

5. Purpose or Purposes for which water is used irrigation

(Domestic, irrigation, municipal, manufacturing, industrial, etc.)

6. Description of Well: Depth 28 feet. Type drilled  
(Dug or drilled)

diameter 10 inches. Elevation of ground at well site 250 feet, mean sea level.  
(As near as known)

Depth to water table 10 feet.

7. Capacity of Well: 700 g.p.m. with no feet drawdown.

\_\_\_\_\_ g.p.m. with \_\_\_\_\_ feet drawdown.

Date of test 1949

If Flowing Well: Measured discharge \_\_\_\_\_ g.p.m. on \_\_\_\_\_  
(Date)


Shut-in pressure at ground surface \_\_\_\_\_ lbs. per sq. in. on \_\_\_\_\_  
(Date)

Water is controlled by \_\_\_\_\_  
(Cap. valve, etc.)





Township 145 Range 5W W.M.  
North

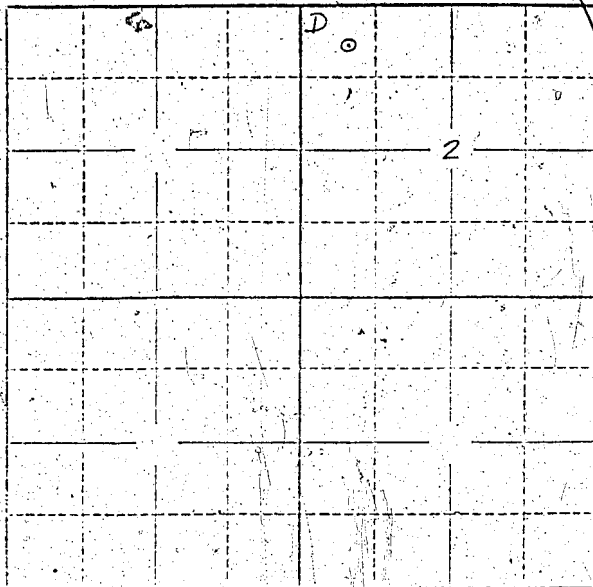

Locate well and acreage of irrigated land on plat.  
Scale: 2" = 1 Mile

STATE OF OREGON }  
County of Benton } ss.

I Julius E. & Phyllis C. Purvine, being first duly sworn, do hereby certify that I have read the foregoing Registration Statement and that all of the items therein contained are true to the best of my knowledge and belief.

.....  
(Signature of Registrant)

Subscribed and sworn to before me this 21 day of April, 1959.

My commission expires July 1960 Notary Public  
(Notary Public)

(SEAL)

### CERTIFICATE OF REGISTRATION

STATE OF OREGON }  
County of Marion } ss.

This is to certify that the foregoing Registration Statement was received in the office of the State Engineer on the 25 day of July, 1958, at 7:20 o'clock A. M. and has been duly recorded in said office in Book No. 11 of Registration Statements on page GR-2583

~~Construction shall be completed by 1959 and the water completely applied to beneficial use by 1960.~~

Witness my hand this 6th day of April, 1959.

.....  
(State Engineer)

By .....  
(Deputy)

GR-2583

\$ 19.95