

# Registration Statement

## OF CLAIMANT OF RIGHT TO APPROPRIATE GROUND WATER

TO THE STATE ENGINEER OF OREGON:

I, Laue Morris

of Rural Route 1, Box 424, Central Point, County of Jackson

State of Oregon, do hereby make application for a certificate of registration as evidence of a right to appropriate ground water.

1. Source from which water is withdrawn is Infiltration Trench  
(Flowing well, pump well, infiltration trench, or tunnel)

2. Location is: 5 miles north of Central Point, Oregon  
(Approximate distance and direction from nearest city or town)

and is more particularly described as follows:

(a) 1116 feet West and 2655 feet North from SE corner of Section 30  
(Give distance and bearing to corner of section or other legal subdivision)

being within SW, SE, NE of Sec. 30, Twp. 36 S., Rge. 2  
(Smallest legal subdivision) (S or S.) (W or W.)

or (b) within limits of recorded platted property, town or city:

in Lot \_\_\_\_\_, Block \_\_\_\_\_ of \_\_\_\_\_  
(Name of plat or addition)

County of \_\_\_\_\_  
(If within city or town, give name)

3. Construction Work was begun on 1953; was completed on 2 days later in  
(Date) (Date)

and the ground water claimed was first used for the purposes set out below on July, 1953  
(Date)

since which time the water has been used continuously  
(Continuously or intermittently)

from July, 1958 to present  
(Date) (Date)

4. Quantity of water claimed and used is 167 gallons per minute; 36 acre feet per year.

5. Purpose or Purposes for which water is used irrigation  
(Domestic, irrigation, municipal, manufacturing, industrial, etc.)

6. Description of Well: Depth \_\_\_\_\_ feet. Type \_\_\_\_\_  
(Dug or drilled)

diameter \_\_\_\_\_ inches. Elevation of ground at well site \_\_\_\_\_ feet, mean sea level.  
(As near as known)

Depth to water table \_\_\_\_\_ feet.

7. Capacity of Well: \_\_\_\_\_ g.p.m. with \_\_\_\_\_ feet drawdown.

\_\_\_\_\_ g.p.m. with \_\_\_\_\_ feet drawdown.

Date of test \_\_\_\_\_

If Flowing Well: Measured discharge \_\_\_\_\_ g.p.m. on \_\_\_\_\_  
(Date)

Shut-in pressure at ground surface \_\_\_\_\_ lbs. per sq. in. on \_\_\_\_\_  
(Date)

Water is controlled by \_\_\_\_\_  
(Cap, valve, etc.)

8. **Casing:** (Give diameter, commercial specifications and depth below ground surface of each casing size.)

..... inch diameter none from ..... to ..... feet  
 ..... inch diameter ..... from ..... to ..... feet  
 ..... inch diameter ..... from ..... to ..... feet  
 ..... inch diameter ..... from ..... to ..... feet

Describe and show depth of shoe, plug, adapter, liner or other details:

none

9. **Perforated Casings or Screens:**

..... none ..... from ..... to .....  
 (Number per foot and size of perforations, or describe screen)  
 ..... from ..... to .....  
 ..... from ..... to .....  
 ..... from ..... to .....

10. **Log of Well:** (Describe each stratum or formation clearly, indicate if water bearing, and give thickness and depth as indicated.)

MATERIAL	Thickness (Feet)	Depth to Bottom (Feet)
<u>not known</u>		

If log of well is not available, give name and address of driller. Gray Mix Concrete Co., 1445 Perry, Grapewin

11. Infiltration Trench: Covered or open open

Dimensions: Length 100 ft. Minimum depth 18 ft. Maximum depth 18 ft.

Bottom width 25 ft. Discharge 167 g.p.m. Date of test July 20, 1958

12. Tunnel: Type of lining none

Dimensions: \_\_\_\_\_  
(Length, course, and cross sectional size)

Position of water bearing stratum with reference to portal of tunnel \_\_\_\_\_

Log of tunnel: (Preceding table for log of well may be used, if desired. Give footage from portal and character of materials, as pertinent.)

13. Pumping Equipment:

(a) Pump Demming Pump (2 to 3 inch centrifugal) Capacity 167 g.p.m.  
(Make, type and size)

(b) Motor 9 H.P. Gasoline Engine  
(Type and horsepower)


14. Location of area irrigated or to be irrigated, or place of use if for purposes other than irrigation.

Township North or South	Range E. or W. of Willamette Meridian	Section	Forty-acre Tract	Number Acres To Be Irrigated	Date of Reclamation
36	2 W.	30	SW $\frac{1}{4}$ SE $\frac{1}{4}$ NE $\frac{1}{4}$	2 acres	July 20, 1958
36	2 W.	30	NW $\frac{1}{4}$ NE $\frac{1}{4}$ SE $\frac{1}{4}$	6 acres <i>8<sup>e</sup></i>	July 20, 1958

15. If the ground water supply is supplemental to an existing water supply, identification of any application for a permit, permit, certificate or adjudicated right to appropriate water made or held by the registrant.  
none

(See attached map.)

Township 36.5 Range 2W, W.M.  
North

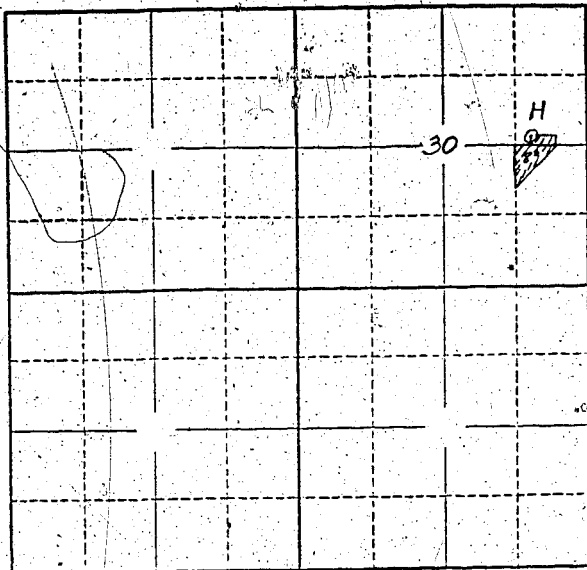

Locate well and acreage of irrigated land on plat.

Scale: 2" = 1 Mile

STATE OF OREGON

County of Jackson } ss.

I, LaRue Morris, being first duly sworn, do hereby certify that I have read the foregoing Registration Statement and that all of the items therein contained are true to the best of my knowledge and belief.

LaRue Morris  
(Signature of Registrant)

Subscribed and sworn to before me this 25th day of July, 1958

My commission expires Nov 5 1960

[Signature]  
(Notary Public)

(SEAL)

**CERTIFICATE OF REGISTRATION**

STATE OF OREGON

County of Marion } ss.

This is to certify that the foregoing Registration Statement was received in the office of the State Engineer on the 28 day of July, 1958, at 8:00 o'clock A. M. and has been duly recorded in said office in Book No. 11 of Registration Statements on page GR-2587

Witness my hand this 6th day of April, 1959

\$1500

[Signature]  
(State Engineer)

By \_\_\_\_\_ (Deputy)

GR-2587