

Registration Statement

OF CLAIMANT OF RIGHT TO APPROPRIATE GROUND WATER

TO THE STATE ENGINEER OF OREGON:

We, Thomas J. Hight and Gertrude M. Hight, husband and wife
of Rt. 1, Box 457-N, Medford County of Jackson
(Mailing address)

State of Oregon, do hereby make application for a certificate of registration as evidence of a right to appropriate ground water.

- 1. Source from which water is withdrawn is 1. humped well
(Flowing well, pump well, infiltration trench, or tunnel)
- 2. Location is: 7 miles northwest of Medford
(Approximate distance and direction from nearest city or town)

and is more particularly described as follows:

- (a) Prox. 150 ft. South 100 ft. East from the NW corner of NW 1/4 of SW 1/4 of SE 1/4
(Give distance and bearing to corner of section or other legal subdivision)
- being within of Sec. 17, Twp. 37 S., Rge. 2 West
(Smallest legal subdivision) (N. or S.) (E. or W.)
- or (b) within limits of recorded platted property, town or city:

in Lot _____, Block _____ of _____
(Name of plat or addition)
County of Jackson
(If within city or town, give name)

- 3. Construction Work was begun on 1944; was completed on 1944
(Date) (Date)

and the ground water claimed was first used for the purposes set out below on _____
(Date)

since which time the water has been used continuously
(Continuously or intermittently)
from 1944 to date
(Date) (Date)

- 4. Quantity of water claimed and used is 25 per min. 1400 per hr. gallons per minute; _____ acre feet per year.

- 5. Purpose or Purposes for which water is used Domestic irrigation
(Domestic, irrigation, municipal, manufacturing, industrial, etc.)

- 6. Description of Well: Depth 231 feet. Type drilled
(Dug or drilled)
diameter 6 inches. Elevation of ground at well site 1750 feet, mean sea level.
(As near as known)

Depth to water table _____ feet.

- 7. Capacity of Well: 1400 hr. g.p.m. with 200 feet drawdown.
_____ g.p.m. with _____ feet drawdown.

Date of test 1944

If Flowing Well: Measured discharge _____ g.p.m. on _____
(Date)

Shut-in pressure at ground surface _____ lbs. per sq. in. on _____
(Date)

Water is controlled by _____
(Cap, valve, etc.)

8. Casing: (Give diameter, commercial specifications and depth below ground surface of each casing size.)

6 inch diameter from surface to 50 feet
 inch diameter from to feet
 inch diameter from to feet
 inch diameter from to feet

Describe and show depth of shoe, plug, adapter, liner or other details: 6" shoe at 50'

9. Perforated Casings or Screens:

..... from to
 (Number per foot and size of perforations, or describe screen)
 from to
 from to
 from to

10. Log of Well: (Describe each stratum or formation clearly, indicate if water bearing, and give thickness and depth as indicated.)

MATERIAL	Thickness (Feet)	Depth to Bottom (Feet)
Decomposed granite and granite diorite.		

If log of well is not available, give name and address of driller. Bob Burns, Grants Pass, Oregon.

11. **Infiltration Trench:** Covered or open _____
 Dimensions: Length _____ ft. Minimum depth _____ ft. Maximum depth _____ ft.
 Bottom width _____ ft. Discharge _____ g.p.m. Date of test _____

12. **Tunnel:** Type of lining _____
 Dimensions: _____
(Length, course, and cross sectional size)
 Position of water bearing stratum with reference to portal of tunnel _____

Log of tunnel: (Preceding table for log of well may be used, if desired. Give footage from portal and character of materials, as pertinent.)

13. **Pumping Equipment:**
 (a) Pump Fairbanks Morse Turbin Capacity 3000 g.p.m. 50 hp. mir.
(Make, type and size)
 (b) Motor GE 5 H.P.
(Type and horsepower)


14. Location of area irrigated or to be irrigated, or place of use if for purposes other than irrigation.

Township North or South	Range E. or W. of Willamette Meridian	Section	Forty-acre Tract	Number Acres To Be Irrigated	Date of Reclamation
37 S	R.2 W	17	SW $\frac{1}{4}$ + SE $\frac{1}{4}$	max. 3 acres	1944

15. If the ground water supply is supplemental to an existing water supply, identification of any application for a permit, permit, certificate or adjudicated right to appropriate water made or held by the registrant.

Township 37 S Range 2 W W.M.

North

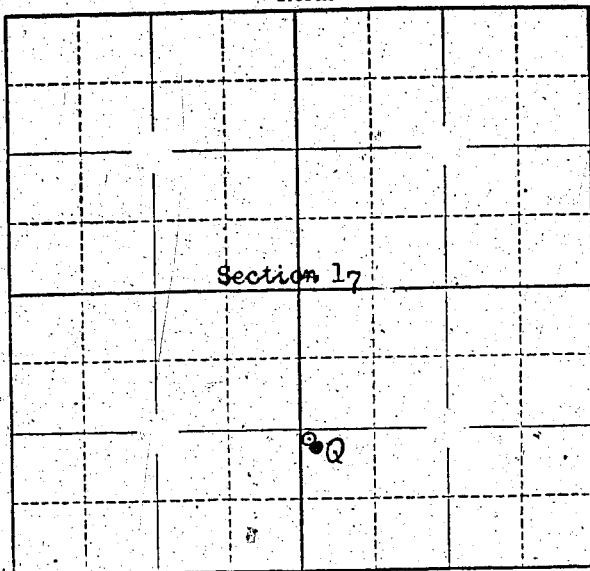

Locate well and acreage of irrigated land on plat.

Scale: $\frac{1}{4}$ " = 1 Mile

STATE OF OREGON

County of Jackson } ss.

We Thomas J. Hight and Gertrude M. Hight, being first duly sworn, do hereby certify that I have read the foregoing Registration Statement and that all of the items therein contained are true to the best of my knowledge and belief.

Thomas J. Hight Gertrude M. Hight
(Signature of Registrant)

Subscribed and sworn to before me this 24th day of July, 1958.

My commission expires May 27, 1959

(Notary Public)

(SEAL)

CERTIFICATE OF REGISTRATION

STATE OF OREGON

County of Marion } ss.

This is to certify that the foregoing Registration Statement was received in the office of the State Engineer on the 25 day of July, 1958, at 5:00 o'clock A.M. and has been duly recorded in said office in Book No. 11 of Registration Statements on page GR 2589

Witness my hand this 6th day of April, 1959

\$15.00

[Signature]
(State Engineer)

By _____ (Deputy)

GR - 2589