

Registration Statement

OF CLAIMANT OF RIGHT TO APPROPRIATE GROUND WATER

TO THE STATE ENGINEER OF OREGON:

I, Milo A. Nelson and Margaret Ann Nelson
 of Rte #2, Box 234, Boring County of Clackamas
(Mailing address)

State of Oregon, do hereby make application for a certificate of registration as evidence of a right to appropriate ground water.

1. Source from which water is withdrawn is Pump well
(Flowing well, pump well, infiltration trench, or tunnel)
2. Location is: Boring, Oreg.
(Approximate distance and direction from nearest city or town)

and is more particularly described as follows:

(a) 3.36' N 1/4 Sec 36, Twp. 13, Rge. 3E
(Give distance and bearing to corner of section or other legal subdivision)
 being within SE 1/4 of Sec. 36, Twp. 13, Rge. 3E
(Smallest legal subdivision) (N. or S.) (E. or W.)

or (b) within limits of recorded platted property, town or city:
 in Lot _____, Block _____ of _____
(Name of plat or addition)

County of Clackamas
(If within city or town, give name)

3. Construction Work was begun on May, 1955; was completed on May, 1955
(Date) (Date)

and the ground water claimed was first used for the purposes set out below on June 10, 1955
(Date)
 since which time the water has been used continuously
(Continuously or intermittently)

from June 1955 to June 1958
(Date) (Date)

4. Quantity of water claimed and used is 60 gallons per minute; 12.5 acre feet per year.

5. Purpose or Purposes for which water is used irrigation & domestic

(Domestic, irrigation, municipal, manufacturing, industrial, etc.)

6. Description of Well: Depth 190 feet. Type drilled
(Dug or drilled)
 diameter 6" inches. Elevation of ground at well site 550 feet, mean sea level.
(As near as known)

Depth to water table 75 feet.

7. Capacity of Well: 100 g.p.m. with 50 feet drawdown.
60 g.p.m. with 35 feet drawdown.

Date of test May, 1955

If Flowing Well: Measured discharge _____ g.p.m. on _____
(Date)

Shut-in pressure at ground surface _____ lbs. per sq. in. on _____
(Date)

Water is controlled by _____
(Cap, valve, etc.)

6" inch diameter from 0 to 190 feet
inch diameter from to feet
inch diameter from to feet
inch diameter from to feet

shoe on pipe at 190

4 slot per ft (Number per foot and size of perforations, or describe screen)	from 100	to 190
3/4" x 2 1/2" Mills perforator	from	to
	from	to
	from	to
	from	to

MATERIAL	Thickness (Feet)	Depth to Bottom (Feet)
Red Clay	1'	70'
cemented gravel	20'	190'
water bearing cement	100'	190'
(This section filled out by well driller owners have no other information - m. shawyer)		

A. O. Olsen

Fresham, Oreg.

11. Infiltration Trench: Covered or open

Dimensions: Length ft. Minimum depth ft. Maximum depth ft.

Bottom width ft. Discharge g.p.m. Date of test

12. Tunnel: Type of lining

Dimensions: _____
(Length, course, and cross sectional size)

Position of water bearing stratum with reference to portal of tunnel

Log of tunnel: (Preceding table for log of well may be used, if desired. Give footage from portal and character of materials, as pertinent.)

13. Pumping Equipment:

(a) Pump 5 H.P. Lineshaft Turbine Capacity 60 g.p.m.
(Make, type and size)

(b) Motor 5 H.P. Hollow shaft motor ELEC
(Type and horsepower)


14. Location of area irrigated or to be irrigated, or place of use if for purposes other than irrigation.

[illegible]

15. If the ground water supply is supplemental to an existing water supply, identification of any application for a permit, permit, certificate or adjudicated right to appropriate water made or held by the registrant.

SEE ATTACHED MAP

Section 36

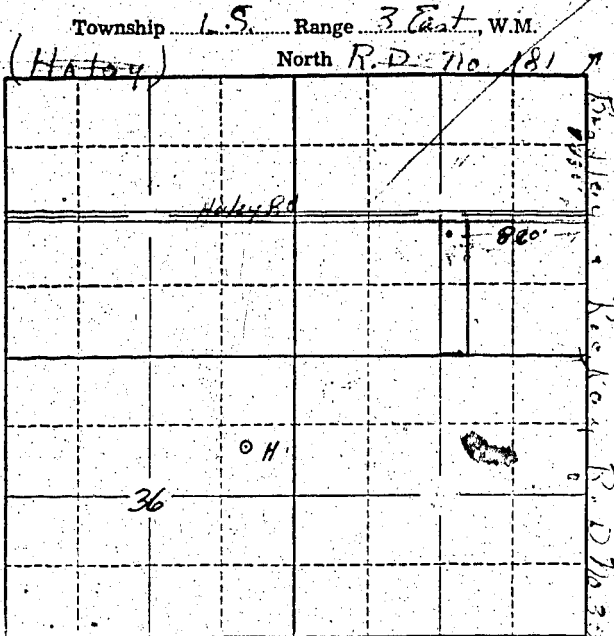

1/4 sec. cor.
 Begin
 10 chains
 west of
 this corner
 20 chains
 south by
 6.5 chains
 wide

Locate well and acreage of irrigated land on plat.

Scale: 2" = 1 Mile

STATE OF OREGON

County of Marion

ss.


 (Signature of Registrant)

Subscribed and sworn to before me this 25th day of April, 1959

My commission expires 12/23/61

(Notary Public)

(SEAL)

CERTIFICATE OF REGISTRATION

STATE OF OREGON

County of Marion

ss.

This is to certify that the foregoing Registration Statement was received in the office of the State Engineer on the 25 day of April, 1959, at 5:15 o'clock A.M. and has been duly recorded in said office in Book No. 11 of Registration Statements on page GR-2590

Witness my hand this 6th day of April, 1959

(State Engineer)

By

(Deputy)

GR - 2590