

Registration Statement

OF CLAIMANT OF RIGHT TO APPROPRIATE GROUND WATER

TO THE STATE ENGINEER OF OREGON:

I, Richard F. Lewman and Daisy V. Lewman

of Box 360 Provolt District, Grants Pass County of Josephine
(Mailing address)

State of Oregon, do hereby make application for a certificate of registration as evidence of a right to appropriate ground water.

1. Source from which water is withdrawn is Infiltration trench
(Flowing well, pump well, infiltration trench, or tunnel)

2. Location is: 18 miles southeast of Grants Pass
(Approximate distance and direction from nearest city or town)

and is more particularly described as follows:

(a) 600 feet south west from the north east corner of SW 1/4 of SE 1/4
(Give distance and bearing to corner of section or other legal subdivision)

being within SW 1/4 of SE 1/4 of Sec. 23, Twp. 38 S, Rge. 5 W
(Smallest legal subdivision) (N. or S.) (E. or W.)

or (b) within limits of recorded platted property, town or city:

in Lot _____, Block _____ of _____
(Name of plat or addition)

County of _____
(If within city or town, give name)

3. Construction Work was begun on Oct. 16, 1946; was completed on Oct. 20, 1946
(Date) (Date)

and the ground water claimed was first used for the purposes set out below on Oct. 24, 1946
(Date)

since which time the water has been used intermittently
(Continuously or intermittently)

from 1946 to 1958
(Date) (Date)

4. Quantity of water claimed and used is 225 gallons per minute; unknown acre feet per year.

5. Purpose or Purposes for which water is used irrigation

(Domestic, irrigation, municipal, manufacturing, industrial, etc.)

6. Description of Well: Depth _____ feet. Type _____
(Dug or drilled)

diameter _____ inches. Elevation of ground at well site _____ feet, mean sea level.
(As near as known)

Depth to water table _____ feet.

7. Capacity of Well: _____ g.p.m. with _____ feet drawdown.

_____ g.p.m. with _____ feet drawdown.


Date of test _____

If Flowing Well: Measured discharge _____ g.p.m. on _____
(Date)

Shut-in pressure at ground surface _____ lbs. per sq. in. on _____
(Date)

Water is controlled by _____
(Cap, valve, etc.)

Township 38 S Range 5 W, W.M.
North

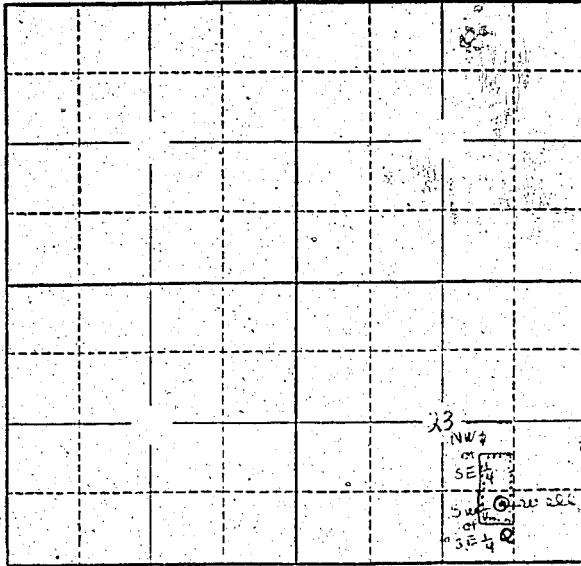

Locate well and acreage of irrigated land on plat.
Scale: 2" = 1 Mile

STATE OF OREGON }
County of Josephine } ss.

I, Richard F. Lewman, being first duly sworn, do hereby certify that I have read the foregoing Registration Statement and that all of the items therein contained are true to the best of my knowledge and belief.

Richard F. Lewman
(Signature of Registrant)

Subscribed and sworn to before me this 27th day of July, 1957

My Commission Expires Oct. 23, 1961
My commission expires _____
(Notary Public)

(SEAL)

CERTIFICATE OF REGISTRATION

STATE OF OREGON }
County of Marion } ss.

This is to certify that the foregoing Registration Statement was received in the office of the State Engineer on the 28th day of July, 1957, at 1:00 o'clock A.M. and has been duly recorded in said office in Book No. 11 of Registration Statements on page GR-2592

Witness my hand this 6th day of April, 1959

Walter A. Starnes
(State Engineer)

By _____
(Deputy)

GR-2592

\$15.00