

# Registration Statement

## OF CLAIMANT OF RIGHT TO APPROPRIATE GROUND WATER

TO THE STATE ENGINEER OF OREGON:

I, C Charles O. Carlberg

of Rt. 4, box 189, Sherwood, Ore County of Washington

State of Oregon, do hereby make application for a certificate of registration as evidence of a right to appropriate ground water.

1. Source from which water is withdrawn is infiltration trench  
(Flowing well, pump well, infiltration trench, or tunnel)

2. Location is: 2 mi. west of Tualatin  
(Approximate distance and direction from nearest city or town)

and is more particularly described as follows:

(a) about 1490 feet east & 1215 feet north from SW corner Section 22  
SE 1/4 of SW 1/4 (Give distance and bearing to corner of section or other legal subdivision)  
being within Tualatin Valley Acres of Sec. 22, Twp. 2 S., Rge. 1 W.  
(Smallest legal subdivision) (N. or S.) (E. or W.)

or (b) within limits of recorded platted property, town or city:

in Lot \_\_\_\_\_ Block \_\_\_\_\_ of \_\_\_\_\_  
(Name of plat or addition)

County of \_\_\_\_\_  
(If within city or town, give name)

3. Construction Work was begun on 1944; was completed on 1945  
(Date) (Date)

and the ground water claimed was first used for the purposes set out below on 1945  
(Date)

since which time the water has been used intermittently  
(Continuously or intermittently)

from 1945 to 1958  
(Date) (Date)

4. Quantity of water claimed and used is 75 gallons per minute; 10 acre feet per year.

5. Purpose or Purposes for which water is used \_\_\_\_\_

irrigation  
(Domestic, irrigation, municipal, manufacturing, industrial, etc.)

6. Description of Well: Depth 12 feet. Type dug  
(Dug or drilled)

diameter 6 inches. Elevation of ground at well site about 220 feet, mean sea level.  
(As near as known)

Depth to water table 5 feet.

7. Capacity of Well: 200 g.p.m. with 1 feet drawdown.

\_\_\_\_\_ g.p.m. with \_\_\_\_\_ feet drawdown.

Date of test \_\_\_\_\_

If Flowing Well: Measured discharge \_\_\_\_\_ g.p.m. on \_\_\_\_\_  
(Date)

Shut-in pressure at ground surface \_\_\_\_\_ lbs. per sq. in. on \_\_\_\_\_  
(Date)

Water is controlled by \_\_\_\_\_  
(Cap, valve, etc.)



If log of well is not available, give name and address of driller. ....

11. Infiltration Trench: Covered or open ..... covered .....

Dimensions: Length about 600 ft. Minimum depth 5 ft. Maximum depth 12 ft.

Bottom width ..... ft. Discharge 150 g.p.m. Date of test .....

12. Tunnel: Type of lining ..... clay tile .....

Dimensions: .....  
(Length, course, and cross sectional size)

Position of water bearing stratum with reference to portal of tunnel .....

Log of tunnel: (Preceding table for log of well may be used, if desired. Give footage from portal and character of materials, as pertinent.)

13. Pumping Equipment:

(a) Pump ..... Fairbanks Morse ..... Capacity 100 g.p.m.

(Make, type and size)

(b) Motor ..... Wisconsin 5 H.P. ....


(Type and horsepower)

14. Location of area irrigated or to be irrigated, or place of use if for purposes other than irrigation.

Township North or South	Range E. or W. of Willamette Meridian	Section	Forty-acre Tract	Number Acres To Be Irrigated	Date of Reclamation
T2S	R1W	22	NW 1/4 of SW 1/4	0.5	1944
"	"	22	NE 1/4 of SW 1/4	1.5	"
"	"	22	SW 1/4 of SW 1/4	6.0	"
"	"	22	SE 1/4 of SW 1/4	2.0	"
				10.0	

15. If the ground water supply is supplemental to an existing water supply, identification of any application for a permit, permit, certificate or adjudicated right to appropriate water made or held by the registrant.

Township 2 S. Range 1 W. W.M. Lots 11-12-13-19 and 20  
 North Tualatin Valley Acres

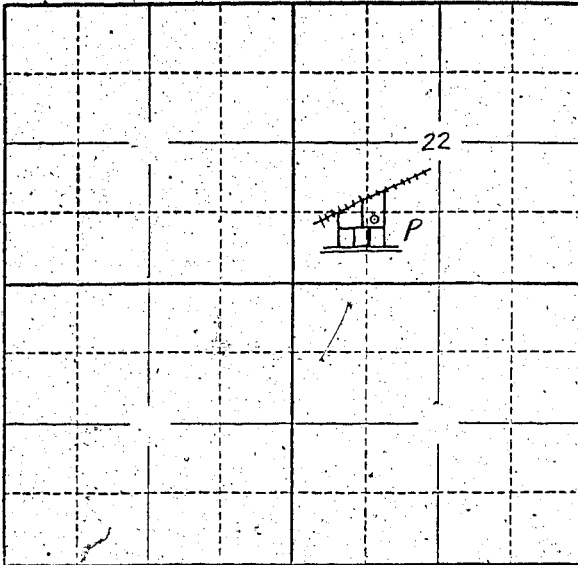

Locate well and acreage of irrigated land on plat.  
 Scale: 2" = 1 Mile

STATE OF OREGON

County of \_\_\_\_\_ } ss.

I, Charles O. Carlberg, being first duly sworn, do hereby certify that I have read the foregoing Registration Statement and that all of the items therein contained are true to the best of my knowledge and belief.

\_\_\_\_\_  
 (Signature of Registrant)

Subscribed and sworn to before me this \_\_\_\_\_ day of \_\_\_\_\_, 19\_\_\_\_

My commission expires Jan 15 - 1959 \_\_\_\_\_  
 (Notary Public)

(SEAL)

**CERTIFICATE OF REGISTRATION**

STATE OF OREGON

County of Marion } ss.

This is to certify that the foregoing Registration Statement was received in the office of the State Engineer on the 25 day of July, 1958, at \_\_\_\_\_ o'clock 11 M. and has been duly recorded in said office in Book No. 11 of Registration Statements on page GR 2597

Witness my hand this 6<sup>th</sup> day of April, 1959

\_\_\_\_\_  
 (State Engineer)

By \_\_\_\_\_  
 (Deputy)

GR - 2597

\$1500