

Registration Statement

OF CLAIMANT OF RIGHT TO APPROPRIATE GROUND WATER

TO THE STATE ENGINEER OF OREGON:

I, Ellert E. Leaning
 of Rt 2 Ex 394, Tillamook County of Tillamook
(Mailing address)
 State of Oregon, do hereby make application for a certificate of registration as evidence of a right to appropriate ground water.

1. Source from which water is withdrawn is pump well
(Flowing well, pump well, infiltration trench, or tunnel)

2. Location is: 2 miles South East of Tillamook
(Approximate distance and direction from nearest city or town)

and is more particularly described as follows:

T1S, R9WWM (a) 670' N and 700' W of SE corner of SE 1/4 of SW 1/4 of Sect. 32,
(Give distance and bearing to corner of section or other legal subdivision)
 being within SE 1/4 of SW 1/4 of Sec. 32, Twp. 1S, Rge. 9 W
(Smallest legal subdivision) (N. or S.) (E. or W.)

or (b) within limits of recorded platted property, town or city: _____

in Lot _____, Block _____ of _____
(Name of plat or addition)

County of _____
(If within city or town, give name)

3. Construction Work was begun on 1951; was completed on 1951
(Date) (Date)

and the ground water claimed was first used for the purposes set out below on 1951
(Date)

since which time the water has been used intermittently (may - etc)
(Continuously or intermittently)
 from 1951 - to 1955
(Date) (Date)

4. Quantity of water claimed and used is 200 gallons per minute; 3 acre feet per year.

5. Purpose or Purposes for which water is used _____

~~Domestic~~ Irrigation
(Domestic, irrigation, municipal, manufacturing, industrial, etc)

6. Description of Well: Depth 70 feet. Type Drilled
(Dug or drilled)

diameter 8 inches. Elevation of ground at well site 20 feet, mean sea level.
(As near as known)

Depth to water table 12 feet.

7. Capacity of Well: 200 g.p.m. with 2 feet drawdown.

_____ g.p.m. with _____ feet drawdown.

Date of test Actual field use


If Flowing Well: Measured discharge _____ g.p.m. on _____
(Date)

Shut-in pressure at ground surface _____ lbs. per sq. in. on _____
(Date)

Water is controlled by _____
(Cap, valve, etc.)

32 sprinklers - 5-6 gal/min

Township 1 S Range 9 W, W.M.
North

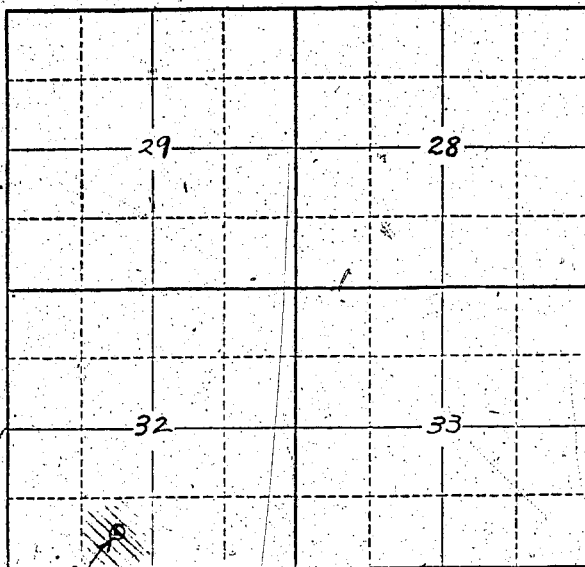

Well. Locate well and acreage of irrigated land on plat.
Scale: 2" = 1 Mile

STATE OF OREGON



.....
(Signature of Registrant)

Subscribed and sworn to before me this day of, 19.....

My commission expires
(Notary Public)

(SEAL)

CERTIFICATE OF REGISTRATION

STATE OF OREGON

County of Marion } ss.

This is to certify that the foregoing Registration Statement was received in the office of the State Engineer on the 22th day of July, 1952, at 2.00 o'clock P.M. and has been duly recorded in said office in Book No. 11 of Registration Statements on page GR-2598.

Witness my hand this 6th day of April, 1959

.....
(State Engineer)

By
(Deputy)

GR - 2598

#16-35