

# Registration Statement

## OF CLAIMANT OF RIGHT TO APPROPRIATE GROUND WATER

R

TO THE STATE ENGINEER OF OREGON:

I, Merwin B. Blank

of 6370 River Road, Linn County, Lane

State of Oregon, do hereby make application for a certificate of registration as evidence of a right to appropriate ground water.

1. Source from which water is withdrawn is Pump Well  
(Flowing well, pump well, infiltration trench, or tunnel)

2. Location is: U.S. quarter section on River Road  
(Approximate distance and direction from nearest city or town)

and is more particularly described as follows:

(a) 660' West from South East corner of Sec. 27 on section line SE 1/4 of SE 1/4  
(Give distance and bearing to corner of section or other legal subdivision)  
being within SE 1/4 of SE 1/4, SW 1/4 SE 1/4, NE 1/4 NE 1/4, NW 1/4 NE 1/4 of Sec. 27, Twp. 16 S. Rge. A W.  
(Smallest legal subdivision) (N. or S.) (E. or W.)

or (b) within limits of recorded platted property, town or city:

in Lot \_\_\_\_\_, Block \_\_\_\_\_ of \_\_\_\_\_  
(Name of plat or addition)

County of \_\_\_\_\_  
(If within city or town, give name)

3. Construction Work was begun on April 1940; was completed on \_\_\_\_\_  
(Date) (Date)

and the ground water claimed was first used for the purposes set out below on 1940  
(Date)

since which time the water has been used intermittently  
(Continuously or intermittently)

from June 1940 to Oct 1954  
(Date) (Date)

4. Quantity of water claimed and used is 120 g.p.m. gallons per minute; 204 acre feet per year.

5. Purpose or Purposes for which water is used Domestic  
(Domestic, irrigation, municipal, manufacturing, industrial, etc.)

6. Description of Well: Depth 205-21 feet. Type \_\_\_\_\_  
(Dug or drilled)

diameter 1 1/2 inches. Elevation of ground at well site \_\_\_\_\_ feet, mean sea level.

Depth to water table 15 feet.

7. Capacity of Well: \_\_\_\_\_ g.p.m. with \_\_\_\_\_ feet drawdown.

\_\_\_\_\_ g.p.m. with \_\_\_\_\_ feet drawdown.

Date of test No. test

If Flowing Well: Measured discharge \_\_\_\_\_ g.p.m. on \_\_\_\_\_  
(Date)

Shut-in pressure at ground surface \_\_\_\_\_ lbs. per sq. in. on \_\_\_\_\_  
(Date)

Water is controlled by \_\_\_\_\_  
(Cap, valve, etc.)

8. Casing: (Give diameter, commercial specifications and depth below ground surface of each casing size.)

3(3") inch diameter from 0 to 2.6 feet  
inch diameter from to feet  
inch diameter from to feet  
inch diameter from to feet

Describe and show depth of shoe, plug, adapter, liner or other details:  
.....  
.....

9. Perforated Casings or Screens:

..... from ..... to .....

(Number per foot and size of perforations, or describe screen)

..... from ..... to .....

..... from ..... to .....

..... from ..... to .....

10. Log of Well: (Describe each stratum or formation clearly, indicate if water bearing, and give thickness and depth as indicated.)

MATERIAL	Thickness (Feet)	Depth to Bottom (Feet)
None		

If log of well is not available, give name and address of driller. *Martin F. Myers*

11. Infiltration Trench: Covered or open .....  
 Dimensions: Length ..... ft. Minimum depth ..... ft. Maximum depth ..... ft.  
 Bottom width ..... ft. Discharge ..... g.p.m. Date of test .....

12. Tunnel: Type of lining .....  
 Dimensions: .....  
(Length, course, and cross section, size)  
 Position of water bearing stratum with reference to portal of tunnel .....

Log of tunnel: (Preceding table for log of well may be used, if desired. Give footage from portal and character of materials, as pertinent.)


13. Pumping Equipment:  
 (a) Pump *Bingham Cent. 1 1/2* Capacity *120* g.p.m.  
(Make, type and size)  
 (b) Motor *5 1/2 E.C.C. Single Phase*  
(Type and horsepower)

14. Location of area irrigated or to be irrigated, or place of use if for purposes other than irrigation.

Township North or South	Range E. or W. of Williamsite Meridian	Section	Forty-acre Tract	Number Acres To Be Irrigated	Date of Reclamation
<del>#</del>				<del>17</del>	
16S	4W.	27	SE 1/4 of SE 1/4	4	1940
16S	4W.	27	SW 1/4 of SE 1/4	1	"
16S	4W.	34	NE 1/4 of NE 1/4	8	"
16S	4W.	34	NW 1/4 of NE 1/4	4	"
				<u>17</u>	"

15. If the ground water supply is supplemental to an existing water supply, identification of any application for a permit, permit, certificate or adjudicated right to appropriate water made or held by the registrant.

Township 16 S Range 4 W, W.M.  
North

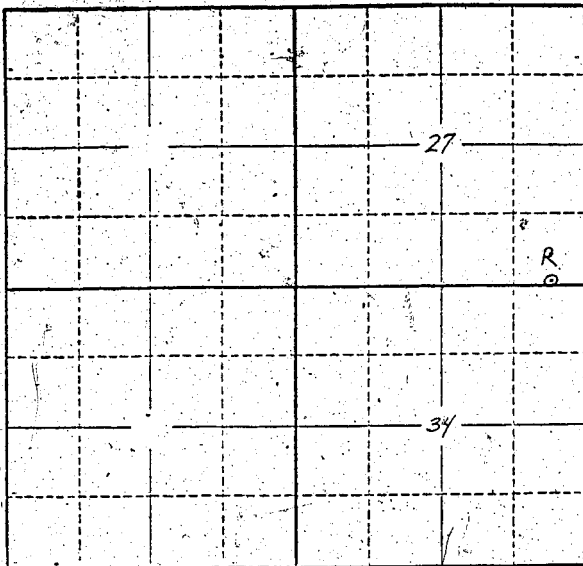

Locate well and acreage of irrigated land on plat.  
Scale: 2" = 1 Mile

STATE OF OREGON

County of Lane } ss.

I, Manuel B. Rankin, being first duly sworn, do hereby certify that I have read the foregoing Registration Statement and that all of the items therein contained are true to the best of my knowledge and belief.

Manuel B. Rankin  
(Signature of Registrant)

Subscribed and sworn to before me this 26th day of April, 1959

My commission expires \_\_\_\_\_  
(Notary Public)

(SEAL)

### CERTIFICATE OF REGISTRATION

STATE OF OREGON } ss.  
County of Marion

This is to certify that the foregoing Registration Statement was received in the office of the State Engineer on the 28th day of July, 1958, at 2:00 o'clock A.M. and has been duly recorded in said office in Book No. 11 of Registration Statements on page GR 2601

Witness my hand this 6th day of April, 1959

Walter L. Davis  
(State Engineer)

By \_\_\_\_\_  
(Deputy)

GR. 2601

4-15-59