

Registration Statement

OF CLAIMANT OF RIGHT TO APPROPRIATE GROUND WATER

TO THE STATE ENGINEER OF OREGON:

I, Magnus Stensrud
 of 1404 N. Killingsworth Portland County of Multnomah
(Mailing address)
 State of Oregon do hereby make application for a certificate of registration as evidence
 of a right to appropriate ground water.

1. Source from which water is withdrawn is Pump Well
(Flowing well, pump well, infiltration trench, or tunnel)
2. Location is: 2 miles Southwest of Astoria on Kinney Road
(Approximate distance and direction from nearest city or town)

and is more particularly described as follows:

(a) S 62°00' E West 1/4 corner Sec 16 670'
(Give distance and bearing to corner of section or other legal subdivision)

being within NW 1/4 SW 1/4 of Sec. 16, Twp. 1 S, Rge. 3 E
(Smallest legal subdivision) (N. or S.) (E. or W.)

or (b) within limits of recorded platted property, town or city:

in Lot _____, Block _____ of _____
(Name of plat or addition)

County of _____
(If within city or town, give name)

3. Construction Work was begun on Aug 8, 1951; was completed on Aug 20, 1951
(Date) (Date)

and the ground water claimed was first used for the purposes set out below on July 1952
(Date)

since which time the water has been used Continuously Intermittently
(Continuously or Intermittently)

from May 1952 to SEPT July 1958
(Date) (Date)

4. Quantity of water claimed and used is 55 ~~100~~ gallons per minute; 8.5 acre
 feet per year.

5. Purpose or Purposes for which water is used Irrigation of Small Fruits
and Veg.
(Domestic, irrigation, municipal, manufacturing, industrial, etc.)

6. Description of Well: Depth 255 feet. Type Drilled
(Dug or drilled)

diameter 8 inches. Elevation of ground at well site 200 feet, mean sea level.
(As near as known)

Depth to water table 170 feet.

7. Capacity of Well: 60 g.p.m. with 40 feet drawdown.

_____ g.p.m. with _____ feet drawdown.

Date of test Aug 20, 1951

If Flowing Well: Measured discharge _____ g.p.m. on _____
(Date)

Shut-in pressure at ground surface _____ lbs. per sq. in. on _____
(Date)

Water is controlled by _____
(Cap. valve, etc.)

8. Casing: (Give diameter, commercial specifications and depth below ground surface of each casing size.)

8 inch diameter from 0 to 195 feet
 inch diameter from to feet
 inch diameter from to feet
 inch diameter from to feet

Describe and show depth of shoe, plug, adapter, liner or other details: 195 ft 8 inches
 Standard Old Steel Pipe With drive shoe


9. Perforated Casings or Screens:

Unknown from to
 (Number per foot and size of perforations, or describe screen)
 from to
 from to
 from to

10. Log of Well: (Describe each stratum or formation clearly, indicate if water bearing, and give thickness and depth as indicated.)

MATERIAL	Thickness (Feet)	Depth to Bottom (Feet)
Yellow clay	45	45
yellow clay and Boulders	25	70
Cemented gravel	50	120
Broken rock	20	140
Cemented gravel	40	180
Gravel & Br. Silty sand w/approx. 4 GPM water	2	182
Rock Gravel	13	195
Rock some broken	50	245
Water bearing lava rock	10	255

Township 15 Range 3E, W.M.
North

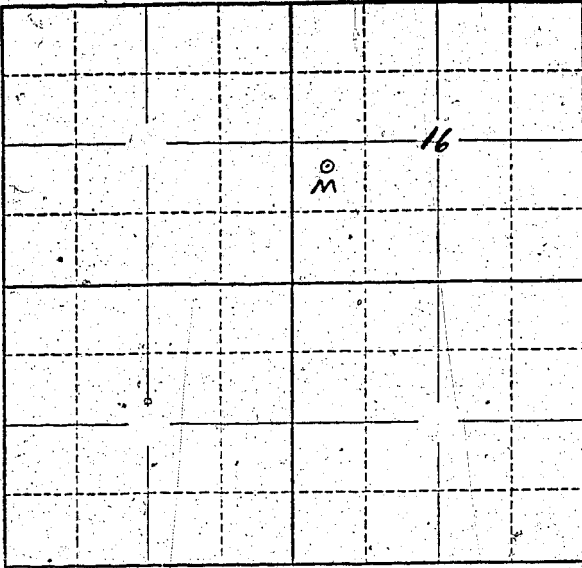

Locate well and acreage of irrigated land on plat.
Scale: 2" = 1 Mile

STATE OF OREGON }
County of Multnomah } ss.

I, _____, being first duly sworn, do hereby certify that I have read the foregoing Registration Statement and that all of the items therein contained are true to the best of my knowledge and belief.

Magnus Steussel
(Signature of Registrant)

Subscribed and sworn to before me this 26 day of July, 1958

My commission expires _____
Brosby C. Taylor
(Notary Public)

(SEAL)

CERTIFICATE OF REGISTRATION

STATE OF OREGON }
County of Marion } ss.

This is to certify that the foregoing Registration Statement was received in the office of the State Engineer on the 28th day of July, 1958, at 8:00 o'clock A.M. and has been duly recorded in said office in Book No. 11 of Registration Statements on page GR-2602

Witness my hand this 6th day of April, 1959.

[Signature]
(State Engineer)

By _____
(Deputy)

GR - 2602

1/500