

Registration Statement

OF CLAIMANT OF RIGHT TO APPROPRIATE GROUND WATER

TO THE STATE ENGINEER OF OREGON:

I, IRVING S HANGER
of R#1 Bx 463 SALEM County of POLK
(Mailing address)

State of Oregon, do hereby make application for a certificate of registration as evidence of a right to appropriate ground water.

1. Source from which water is withdrawn is PUMP WELL
(Flowing well, pump well, infiltration trench, or tunnel)

2. Location is: Lincoln
(Approximate distance and direction from nearest city or town)

and is more particularly described as follows: 1750 ft west & 850 feet south from NE corner Section 20
10 chs NE 1/2 SW 1/4 from SW cor Thomas Plc 55

(a) NW 1/4 NE 1/4 (Give distance and bearing to corner of section or other legal subdivision)

being within 20 of Sec. 20, Twp. 6S, Rge. 3W
(Smallest legal subdivision) (N. or S.) (E. or W.)

or (b) within limits of recorded platted property, town or city: Lincoln

in Lot _____, Block _____ of _____
(Name of plat or addition)

Lincoln County of Polk
(If within city or town, give name)

3. Construction Work was begun on 1941; was completed on _____
(Date) (Date)

and the ground water claimed was first used for the purposes set out below on Not Known
(Date)

since which time the water has been used Continuously
(Continuously or Intermittently)

from 5-1-41 to 10-1-58
(Date) (Date)

4. Quantity of water claimed and used is 160 gallons per minute; 85 acre feet per year.

5. Purpose or Purposes for which water is used IRRIGATION
(Domestic, irrigation, municipal, manufacturing, industrial, etc.)

6. Description of Well: Depth 24 feet. Type Drilled
(Dug or drilled)

diameter 8 inches. Elevation of ground at well site 3' feet, mean sea level.
(As near as known)

Depth to water table 5 feet.

7. Capacity of Well: _____ g.p.m. with _____ feet drawdown. No Test

_____ g.p.m. with _____ feet drawdown.

Date of test _____

If Flowing Well: Measured discharge _____ g.p.m. on _____
(Date)

Shut-in pressure at ground surface _____ lbs. per sq. in. on _____
(Date)

Water is controlled by Valve
(Cap, valve, etc.)

8. Casing: (Give diameter, commercial specifications and depth below ground surface of each casing size.)

8 inch diameter from 0^o to 22 feet
..... inch diameter from to feet
..... inch diameter from to feet
..... inch diameter from to feet

Describe and show depth of shoe, plug, adapter, liner or other details:

not shown

9. Perforated Casings or Screens:

..... from to
(Number per foot and size of perforations, or describe screen)
..... from to
..... from to
not shown from to

10. Log of Well: (Describe each stratum or formation clearly, indicate if water bearing, and give thickness and depth as indicated.)

MATERIAL	Thickness (Feet)	Depth to Bottom (Feet)
<i>not available</i>		

If log of well is not available, give name and address of driller. *Not None*

11. Infiltration Trench: Covered or open

Dimensions: Length ft. Minimum depth ft. Maximum depth ft.

Bottom width ft. Discharge g.p.m. Date of test

12. Tunnel: Type of lining

Dimensions: (Length, cover and gross sectional size)

Position of water bearing stratum with reference to portal of tunnel

Log of tunnel: (Preceding table for log of well may be used, if desired. Give footage from portal and character of materials, as pertinent.)

13. Pumping Equipment:

(a) Pump *Pacific Cent 4"* Capacity *180* g.p.m.
(Make, type and size)


(b) Motor *Wagner 7 1/2* *220 3 phase*
(Type and horsepower)

14. Location of area irrigated or to be irrigated, or place of use if for purposes other than irrigation.

Township North or South	Range E. or W. of Willamette Meridian	Section	Forty-acre Tract	Number Acres To Be Irrigated	Date of Reclamation
65	3W	17	SW 1/4 SE 1/4	0.1	1941
"	"	20	NE 1/4 NE 1/4	9.8	1941
"	"	"	NW 1/4 NE 1/4	22.8	1941
"	"	"	SW 1/4 NE 1/4	1.4	1941
"	"	"	SE 1/4 NE 1/4	1.2	1941
				<u>35.3</u>	

15. If the ground water supply is supplemental to an existing water supply, identification of any application for a permit, permit, certificate or adjudicated right to appropriate water made or held by the registrant.

Township 6 S Range 3 W W.M.
North

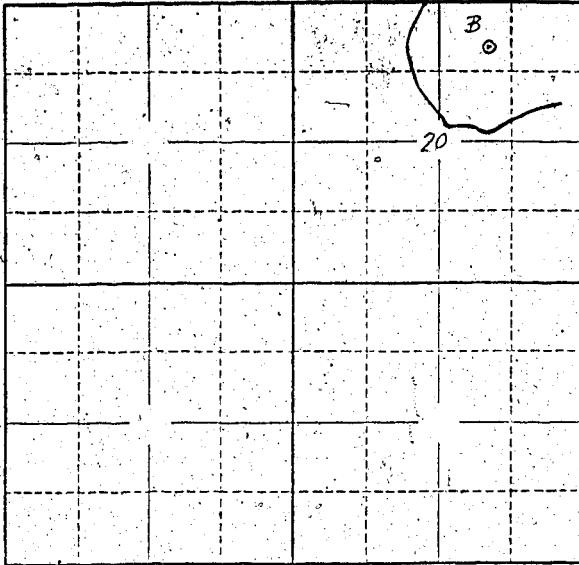

Locate well and acreage of irrigated land on plat.
Scale: 2" = 1 Mile

STATE OF OREGON }
County of Marion } ss.

I, _____, being first duly sworn, do hereby certify that I have read the foregoing Registration Statement and that all of the items therein contained are true to the best of my knowledge and belief.

Irving S. Hanger
(Signature of Registrant)

Subscribed and sworn to before me this 28th day of July, 1958.

My commission expires 12th June 1961 Wm. S. Bartholomew
(Notary Public)

(SEAL)

CERTIFICATE OF REGISTRATION

STATE OF OREGON }
County of Marion } ss.

This is to certify that the foregoing Registration Statement was received in the office of the State Engineer on the 28th day of July, 1958, at 9:30 o'clock A. M. and has been duly recorded in said office in Book No. 11 of Registration Statements on page GR-2606.

Witness my hand this 6th day of April, 1959.

Wm. S. Bartholomew
(State Engineer)

By _____
(Deputy)

GR - 2606

\$15.90