

# Registration Statement

## OF CLAIMANT OF RIGHT TO APPROPRIATE GROUND WATER

### TO THE STATE ENGINEER OF OREGON:

I, THEO VAN DONINCK

of 720 WEST DIVISION STREET, GRESHAM, OREGON County of MULTNOMAH

(Mailing address)

State of OREGON do hereby make application for a certificate of registration as evidence of a right to appropriate ground water.

1. Source from which water is withdrawn is PUMP WELL  
(Flowing well, pump well, infiltration trench, or tunnel)

2. Location is: 720 WEST DIVISION STREET, GRESHAM, OREGON

(Approximate distance and direction from nearest city or town)

and is more particularly described as follows: 1310 feet east & 150 feet south from N 1/4 corner Section 9.

(a) NE CORNER, LOT 12, CASCADE VIEW ACRES, 35' WEST AND 115' SOUTH  
(Give distance and bearing to corner of section or other legal subdivision)

being within LOT 12 NW 1/4 of NE 1/4 of Sec. 9, Twp. 1S, Rge. 3E  
(Smallest legal subdivision) (N. or S.) (E. or W.)

or (b) within limits of recorded platted property, town or city: GRESHAM, OREGON

in Lot 12, Block \_\_\_\_\_ of CASCADE VIEW ACRES  
(Name of plat or addition)

GRESHAM County of MULTNOMAH  
(If within city or town, give name)

3. Construction Work was begun on JULY, 1952; was completed on JULY, 1952  
(Date) (Date)

and the ground water claimed was first used for the purposes set out below on JULY, 1952  
(Date)

since which time the water has been used INTERMITTENTLY  
(Continuously or Intermittently)

from JULY, 1952 to PRESENT  
(Date) (Date)

4. Quantity of water claimed and used is 20 gallons per minute; \_\_\_\_\_ acre feet per year.

5. Purpose or Purposes for which water is used IRRIGATION AND DOMESTIC

(Domestic, irrigation, municipal, manufacturing, industrial, etc.)

6. Description of Well: Depth 139 feet. Type DRILLED

(Dug or drilled)

diameter 6 inches. Elevation of ground at well site 300' feet, mean sea level.  
(As near as known)

Depth to water table 84 feet.

7. Capacity of Well: 20 g.p.m. with 50 feet drawdown.

\_\_\_\_\_ g.p.m. with \_\_\_\_\_ feet drawdown.

Date of test \_\_\_\_\_

If Flowing Well: Measured discharge \_\_\_\_\_ g.p.m. on \_\_\_\_\_

(Date)

Shut-in pressure at ground surface \_\_\_\_\_ lbs. per sq. in. on \_\_\_\_\_

(Date)


Water is controlled by \_\_\_\_\_

(Cap, valve, etc.)





Township 15 Range 3E, W.M. SECT. 9  
North

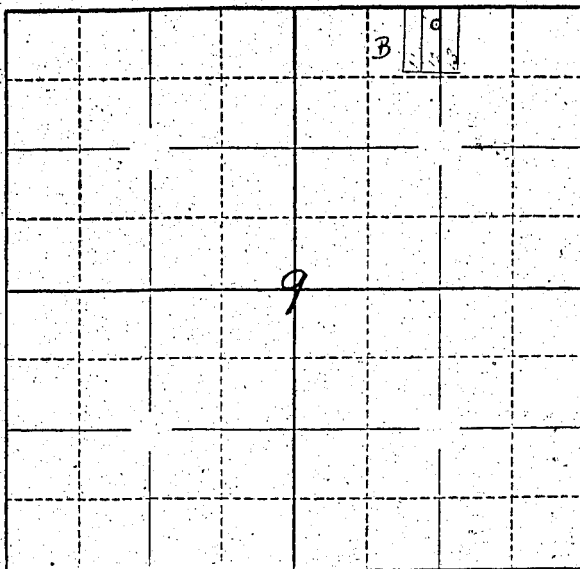

NE $\frac{1}{4}$  = NE $\frac{1}{4}$  - 1 LOT  
NW $\frac{1}{4}$  = NE $\frac{1}{4}$  - 2 LOTS

Locate well and acreage of irrigated land on plat.  
Scale: 2" = 1 Mile

STATE OF OREGON

County of MULTNOMAH } ss.

I, THEO VAN DONINK, being first duly sworn, do hereby certify that I have read the foregoing Registration Statement and that all of the items therein contained are true to the best of my knowledge and belief.

Theo Van Donink  
(Signature of Registrant)

Subscribed and sworn to before me this 18 day of July, 1958.

My commission expires August 29, 1961  
Richard J. [Signature]  
(Notary Public)

(SEAL)

**CERTIFICATE OF REGISTRATION**

STATE OF OREGON } ss.  
County of Marion

This is to certify that the foregoing Registration Statement was received in the office of the State Engineer on the 28th day of July, 1958, at 10:30 o'clock A.M. and has been duly recorded in said office in Book No. 11 of Registration Statements on page GR 2611

Witness my hand this 6th day of April, 1959.

see

[Signature]  
(State Engineer)

By \_\_\_\_\_ (Deputy)