

Registration Statement

REGISTRATION NO. GR-2767  
CERTIFICATE NO. GR 2616

OF CLAIMANT OF RIGHT TO APPROPRIATE GROUND WATER

(Under Chapter 708, Oregon Laws 1955.)

TO THE STATE ENGINEER OF OREGON:

I, George Feiry Attn: Box 216  
of Stayton Oregon County of Manion  
State of Oregon do hereby make application for a certificate of registration as evidence of a right to appropriate ground water:

1. Source from which water is withdrawn is Well Infiltration Trench  
(Flowing well, pump well, infiltration trench, or tunnel)

2. Location is: 2 miles west from Stayton Ore  
(Approximate distance and direction from nearest city or town)

and is more particularly described as follows:

(a) 1900 ft. South 450 ft. west of the N.E. Corner  
(Give distance and bearing to corner of section or other legal subdivision)

being within S.E. 1/4 of N.E. 1/4 of Sec. 17, Twp. 9S, Rge. 1W  
(Smallest legal subdivision) (N. or S.) (E. or W.)

or (b) within limits of recorded platted property, town or city:

in Lot \_\_\_\_\_ Block \_\_\_\_\_ of \_\_\_\_\_  
(Name of plat or addition)

County of \_\_\_\_\_  
(If within city or town, give name)

3. Construction Work was begun on April 1950; was completed on April 1950  
(Date) (Date)

and the ground water claimed was first used for the purposes set out below on July 1950  
(Date)

since which time the water has been used intermittently  
(Continuously or intermittently)

from June 1950 to July 1958  
(Date) (Date)

4. Quantity of water claimed and used is 136 gallons per minute; \_\_\_\_\_ acre feet per year.

5. Purpose or Purposes for which water is used Irrigation

Sump (Domestic, irrigation, municipal, manufacturing, industrial, etc.)

6. Description of Well: Depth 12 feet. Type Dug  
(Dug or drilled)

diameter \_\_\_\_\_ inches. Elevation of ground at well site \_\_\_\_\_ feet, mean sea level.  
(As near as known)

Depth of water table \_\_\_\_\_ feet.

7. Capacity of Well: 400 g.p.m. with 5 feet drawdown.

\_\_\_\_\_ g.p.m. with \_\_\_\_\_ feet drawdown.

Date of test \_\_\_\_\_

If Flowing Well: Measured discharge \_\_\_\_\_ g.p.m. on \_\_\_\_\_  
(Date)

Shut-in pressure at ground surface \_\_\_\_\_ lbs. per sq. in. on \_\_\_\_\_  
(Date)

Water is controlled by \_\_\_\_\_  
(Cap. valve, etc.)



If log of well is not available, give name and address of driller: .....

11. Infiltration Trench: Covered or open Open  
 Dimensions: Length 60 ft. Minimum depth 12 ft. Maximum depth 12 ft.  
 Bottom width 18 ft. Discharge 136 g.p.m. Date of test .....

12. Tunnel: Type of lining .....  
 Dimensions: .....  
(Length, course, and cross sectional size)  
 Position of water bearing stratum with reference to trial of tunnel .....

Log of tunnel: (Preceding table for log of well may be used, if desired. Give footage from portal and character of materials, as pertinent.)


13. Pumping Equipment:  
 (a) Pump Pacific Cent Capacity 200 g.p.m.  
(Make, type and size)  
 (b) Motor 10 H.P.  
(Type and horsepower)

14. Location of area irrigated or to be irrigated, or place of use if for purposes other than irrigation.

Township North or South	Range E. or W. of Willamette Meridian	Section	Forty-acre Tract	Number Acres To Be Irrigated	Date of Reclamation
<del>93</del>	<u>TW</u>	<u>17</u>	<u>S.E. 1/4 N.E. 1/4</u>	<u>25</u>	<u>1950</u>
<u>"</u>	<u>"</u>	<u>16</u>	<u>S.W. 1/4 N.W. 1/4</u>	<u>12</u>	<u>"</u>
				<u>37.0</u>	

15. If the ground water supply is supplemental to an existing water supply, identification of any application for a permit, permit, certificate or adjudicated right to appropriate water made or held by the registrant.

Township T. 9 S. Range R. 1 W. N.M.  
North

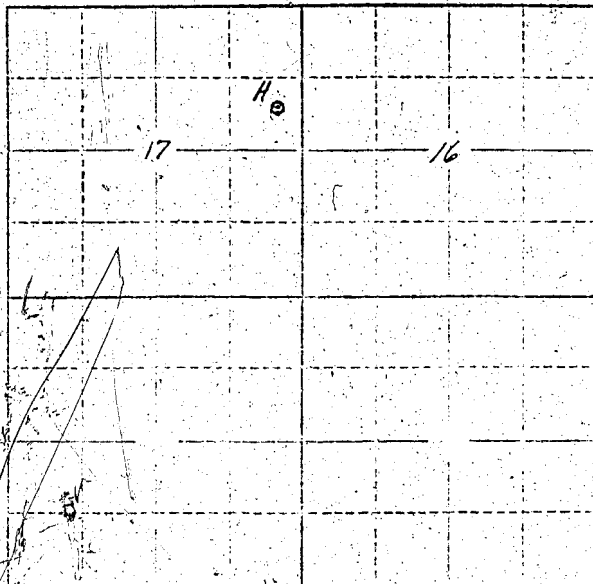

Locate well and acreage of irrigated land on plat.  
Scale: 2" = 1 Mile

STATE OF OREGON

County of Marion

I, George Day, being first duly sworn, do hereby certify that I have read the foregoing Registration Statement and that all of the items therein contained are true to the best of my knowledge and belief.

George Day  
Signature of Registrant

Subscribed and sworn to before me this 28th day of July 1958

My commission expires 12th June 1961  
Wm. S. Bartholomew  
(Notary Public)

(SEAL)

**CERTIFICATE OF REGISTRATION**

STATE OF OREGON

County of Marion

This is to certify that the foregoing Registration Statement was received in the office of the State Engineer on the 28th day of July, 1958, at 10:30 o'clock A. M. and has been duly recorded in said office in Book No. 11 of Registration Statements on page GR-2616

~~Construction shall be completed by 19... and the water complete registration beneficial use by 19...~~

Witness my hand this 6th day of April 1959

(State Engineer)

By \_\_\_\_\_  
(Deputy)

#1605

GR-2616