

Registration Statement

REGISTRATION NO. *GR-2768*
CERTIFICATE NO. *GR-2617*

OF CLAIMANT OF RIGHT TO APPROPRIATE GROUND WATER

(Under Chapter 708, Oregon Laws 1955.)

TO THE STATE ENGINEER OF OREGON:

I, *George Levy* of *Stayton* County of *Morison* State of *Oregon*

do hereby make application for a certificate of registration as evidence of a right to appropriate ground water.

1. Source from which water is withdrawn is *Infiltration trench #2*
(Flowing well, pump well, infiltration trench, or tunnel)
2. Location is: *2 miles west of Stayton*
(Approximate distance and direction from nearest city or town)

and is more particularly described as follows:

(a) *2100 ft N. 550 W from S.E. Corner Section 17*
(Give distance and bearing to corner of section or other legal subdivision)

being within *N.E. 6 S.E.* of Sec. *17*, Twp. *9S*, Rge. *1W*
(Smallest legal subdivision) (N. or S.) (E. or W.)

or (b) within limits of recorded platted property, town or city:

in Lot _____, Block _____ of _____
(Name of plat or addition)

County of _____
(If within city or town, give name)

3. Construction Work was begun on *Apr 1951*, was completed on *April 1951*
(Date) (Date)

and the ground water claimed was first used for the purposes set out below on *July 1951*
(Date)

since which time the water has been used *Intermittently*
(Continuously or Intermittently)

from *July 1951* to *July 1958*
(Date) (Date)

4. Quantity of water claimed and used is *192* gallons per minute; _____ acre feet per year.

5. Purpose or Purposes for which water is used *Irrigation*

6. Description of ^{*Sump*} Well: (Domestic, irrigation, municipal, manufacturing, industrial, etc.) Depth *12* feet, Type *Dug*
(Dug or drilled)

diameter _____ inches. Elevation of ground at well site _____ feet, mean sea level.
(As near as known)

Depth to water table _____ feet.

7. Capacity of Well: _____ g.p.m. with _____ feet drawdown.

_____ g.p.m. with _____ feet drawdown.

Date of test _____

If Flowing Well: Measured discharge _____ g.p.m. on _____
(Date)

Shut-in pressure at ground surface _____ lbs. per sq. in. on _____
(Date)

Water is controlled by _____
(Cm. valve, etc.)

8. **Casing:** (Give diameter, commercial specifications and depth below ground surface of each casing size.)

..... inch diameter from to feet
..... inch diameter from to feet
..... inch diameter from to feet
..... inch diameter from to feet

Describe and show depth of shoe, plug, adapter, liner or other details:

9. **Perforated Casings or Screens:**

..... (Number per foot; and size of perforations, or describe screen) from to
..... from to
..... from to
..... from to

10. **Log of Well:** (Describe each stratum or formation clearly, indicate if water bearing, and give thickness and depth as indicated.)

MATERIAL	Thickness (Feet)	Depth to Bottom (Feet)

If log of well is not available, give name and address of driller.

11. Infiltration Trench: Covered or open

Dimensions: Length 12 ft. Minimum depth 12 ft. Maximum depth

Bottom width 10 ft. Discharge 192 g.p.m. Date of test

12. Tunnel: Type of lining

Dimensions:

(Length, course, and cross sectional size)

Position of water bearing stratum with reference to portal of tunnel

Log of tunnel: (Preceding table for log of well may be used, if desired. Give footage from portal and character of materials, as pertinent.)

13. Pumping Equipment:

(a) Pump Pacific Cent. Capacity 195 g.p.m.
(Make, type and size)


(b) Motor 10 HP
(Type and horsepower)

14. Location of area irrigated or to be irrigated, or place of use if for purposes other than irrigation.

Township North or South	Range E. or W. of Willamette Meridian	Section	Forty-acre Tract	Number Acres To Be Irrigated	Date of Reclamation
9S	1W	17	N1E6S1E	33	1951
11	11	11	S1E6N1E	2	"
11	"	161	N1W6S1W	16	"
				51	"

15. If the ground water supply is supplemental to an existing water supply, identification of any application for a permit, permit, certificate or adjudicated right to appropriate water made or held by the registrant.

Township 9S Range 1W W.M.
North

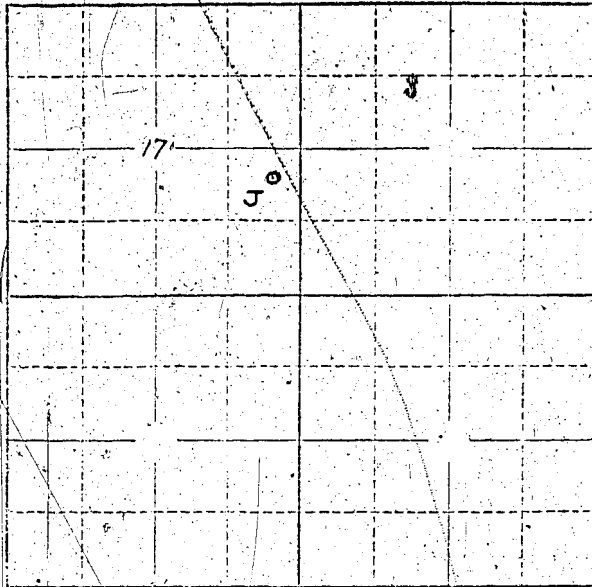

Locate well and acreage of irrigated land on plat.
Scale: 2" = 1 Mile

STATE OF OREGON }
County of Marion } ss.

I, George Henry, being first duly sworn, do hereby certify that I have read the foregoing Registration Statement and that all of the items therein contained are true to the best of my knowledge and belief.

George Henry
(Signature of Registrant)

Subscribed and sworn to before me this 28 day of July, 1958

My commission expires 12th June 1961 W.M.S. Bartholomew
(Notary Public)

(SEAL)

CERTIFICATE OF REGISTRATION

STATE OF OREGON }
County of Marion } ss.

This is to certify that the foregoing Registration Statement was received in the office of the State Engineer on the 28th day of July, 1958, at 10:30 o'clock A. M. and has been duly recorded in said office in Book No. 11 of Registration Statements on page OR-2617

~~Construction shall be completed by 1959 and the water completely applied to beneficial use by 1959.~~

Witness my hand this 6th day of April, 1959

W.M.S. Bartholomew
(State Engineer)

1815

By W.M.S. Bartholomew
(Deputy)

OR-2617